

Marshall  
 N 15  
 6-27-70

MISSISSIPPI  
 BOARD OF WATER COMMISSIONERS  
 416 North State Street  
 Jackson, Mississippi 39201

**CODED**

WATER WELL DRILLERS LOG

6-27 1970 to A. Keison & Frost Marshall  
 date well completed firm name county well located

LANDOWNER:  
B. B. Sims  
Holly Springs Miss  
 (mailing address)

description of formations encountered	from	to
<del>red</del> Bushy part Clay	0	15
Red sand	15	40
white clay	40	55
white sand	55	130
white clay	130	135
white sand	135	160

WELL LOCATION:  
 sec. 4 T 4 N R. 4 E  
4 miles NE of MARIANNA  
 (distance) (direction) (nearest town)

WELL PURPOSE:  
 (home, irrigation, municipal, industrial)

- WELL COMPLETION DATA:
- (1) diameter (inches) 4"
  - (2) total depth (feet) 160
  - (3) static water level (feet) \_\_\_\_\_ below/above top of ground.
  - (4) casing PVC 150  
 (material) (depth)
  - \_\_\_\_\_ if telescope see back.  
 (size)
  - (5) screen 10 FT 150  
 (length) (depth to top)
  - \_\_\_\_\_ (size) \_\_\_\_\_ (material)
  - (6) pump 3 10  
 (HP) (yield gpm)
  - ELC  
 (type power)
  - (7) electric log \_\_\_\_\_ (yes or no)
  - \_\_\_\_\_ (organization running log)
  - (8) how well bottom plugged \_\_\_\_\_

**CODED**


JUL 10 1970

DRILLERS REMARKS:  
 \_\_\_\_\_  
 \_\_\_\_\_

MISS. BO. OF WATER COMMISSIONERS

If well telescopes please sketch and show depths.

GROUND LEVEL

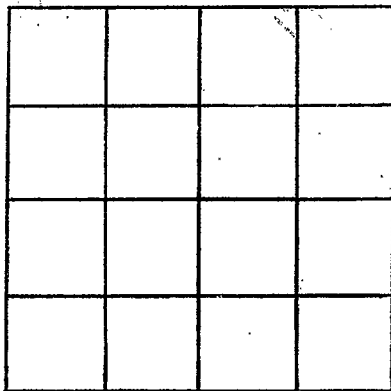

SECTION \_\_\_\_\_

Please indicate well location X.

ADDITIONAL INFORMATION

If more than one screen, show locations of each on sketch.