

MARSHALL
N16
70

MISSISSIPPI
 BOARD OF WATER COMMISSIONERS
 416 North State Street
 Jackson, Mississippi 39201

CODED

WATER WELL DRILLERS LOG

Atkinson & Frost

Marshall

date well completed

firm name

county well located

LANDOWNER: *James Johnson*

description of formations encountered

from to

Byhalia Miss
 (mailing address)

Red clay 0 15
Red sand 15 50
White sand 50 90
White clay 90 95
White sand 95 155

WELL LOCATION:

sec. 4 T. 4 N. R. 4 E.
 10 miles NE of Chalukhoma
 (distance) (direction) (nearest town)

WELL PURPOSE: home
 (home, irrigation, municipal, industrial)

WELL COMPLETION DATA:

- (1) diameter (inches) 4"
- (2) total depth (feet) 155'
- (3) static water level (feet) 130 below top of ground.
- (4) casing P.V.C., 155'
 (material) (depth)
- (size) if telescope see back.
- (5) screen 10', 145'
 (length) (depth to top)
4", P.V.C. + SAND
 (size) (material)
- (6) pump 3/4, 12
 (HP) (yield gpm)
Elec.
 (type power)
- (7) electric log yes or no

CODED

(organization running log)

(8) how well bottom plugged cap.


OCT 13 1970

DRILLERS REMARKS:

MISS. BD. OF
 WATER COMMISSIONERS

If well telescopes please sketch and show depths.

GROUND LEVEL

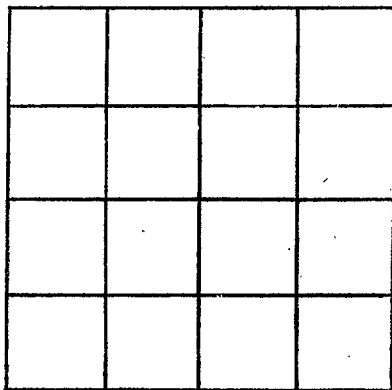

SECTION _____

Please indicate well location X.

ADDITIONAL INFORMATION

If more than one screen, show locations of each on sketch.