

MARSHALL
N 17
12-20-70

MISSISSIPPI
 BOARD OF WATER COMMISSIONERS
 416 North State Street
 Jackson, Mississippi 39201

CODED

WATER WELL DRILLERS LOG

Dec 20 70 19 Wilson Well Co. Marshall
 date well completed firm name county well located

LANDOWNER: William Raford
Holly Springs
Rt 57
 (mailing address)

| description of formations encountered | from | to |
|---------------------------------------|------------|------------|
| <u>Clay</u> | <u>0</u> | <u>10</u> |
| <u>Sand</u> | <u>10</u> | <u>85</u> |
| <u>White Clay</u> | <u>85</u> | <u>100</u> |
| <u>Water Sand</u> | <u>100</u> | <u>160</u> |

WELL LOCATION:
 sec 33 T H N R H E
 miles _____ of _____
 (distance) (direction) (nearest town)

WELL PURPOSE:
 (home, irrigation, municipal, industrial)

WELL COMPLETION DATA:

- (1) diameter (inches) 4
- (2) total depth (feet) 160
- (3) static water level (feet) 130 below top of ground.
- (4) casing Plastic 160
 (material) (depth)
 _____ if telescope see back.
 (size)
- (5) screen 7 160
 (length) (depth to top)
4 Plastic
 (size) (material)
- (6) pump 3/4 10
 (HP) (yield gpm)
Electric
 (type power)
- (7) electric log _____
 (yes or no)

 (organization running log)
- (8) how well bottom plugged _____

CODED


JAN 28 1971

MISS. DD. 05
 WATER BOARD

DRILLERS REMARKS:

If well telescopes please sketch and show depths.

GROUND LEVEL

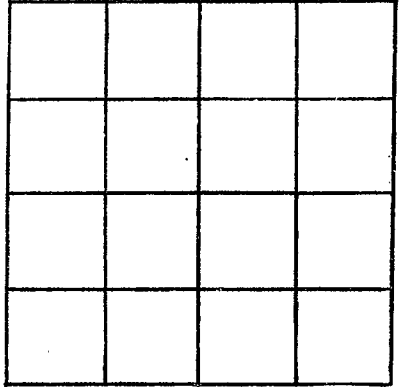

SECTION _____

Please indicate well location X.

ADDITIONAL INFORMATION

If more than one screen, show locations of each on sketch.