

MARSHALL
 N18
 70

MISSISSIPPI
 BOARD OF WATER COMMISSIONERS
 416 North State Street
 Jackson, Mississippi 39201

CODED

WATER WELL DRILLERS LOG

19 Atkinson & Frost firm name Marshall county well located

date well completed

firm name

county well located

LANDOWNER: Henry Bayford
Byhalia Miss.

description of formations encountered

from to

CLAY	0	15
Red SAND	15	60
White SAND	60	115

(mailing address)

WELL LOCATION:

sec. 4 T 4 N R 4 E
5 miles W of MARIANNA
 (distance) (direction) (nearest town)

WELL PURPOSE:

(home, irrigation, municipal, industrial)

WELL COMPLETION DATA:

- (1) diameter (inches) 4"
- (2) total depth (feet) 115
- (3) static water level (feet) 95 below above top of ground.
- (4) casing P.V.C. 115
 (material) (depth)
- (size) if telescope see back.
- (5) screen 10' 105
 (length) (depth to top)
- 4" P.V.C.
 (size) (material)
- (6) pump 3/4 12
 (HP) (yield gpm)
- Elec.
 (type power)
- (7) electric log NO
 (yes or no)

(organization running log)

(8) how well bottom plugged CMP.

CODED


JAN 21 1971

DRILLERS REMARKS:

MISS. BD. OF
 WATER COMMISSIONERS

If well telescopes please sketch and show depths.

GROUND LEVEL

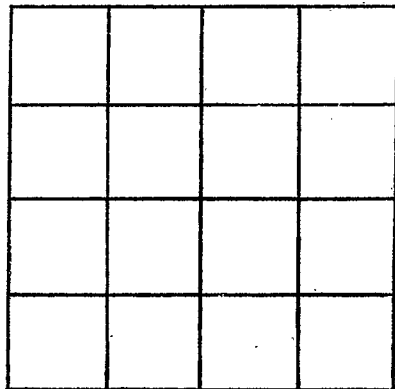

SECTION _____

Please indicate well location X.

ADDITIONAL INFORMATION

If more than one screen, show locations of each on sketch.