

Marshall  
N-21  
S-71

MISSISSIPPI  
BOARD OF WATER COMMISSIONERS  
416 North State Street  
Jackson, Mississippi 39201

WATER WELL DRILLERS LOG

**CODED**

*Atkinson & Frost* Marshall

19 date well completed

firm name

county well located

LANDOWNER: *James Street*  
*R#3 Eudelia Miss*

description of formations encountered	from	to
<i>Clay</i>	<i>0</i>	<i>20</i>
<i>sand</i>	<i>20</i>	<i>85</i>
<i>Clay</i>	<i>85</i>	<i>100</i>
<i>with the sand</i>	<i>100</i>	<i>140</i>

(mailing address)

WELL LOCATION:  
sec. 4 T. 4 N. R. 4 E  
4 miles SE of Watson  
(distance) (direction) (nearest town)

WELL PURPOSE: home  
(home, irrigation, municipal, industrial)

WELL COMPLETION DATA:  
(1) diameter (inches) 4"  
(2) total depth (feet) 140  
(3) static water level (feet) 88' below above top of ground.  
(4) casing P.V.C. 140  
(material) (depth)

**CODED**

(size) if telescope see back.  
(5) screen 10' 130'  
(length) (depth to top)  
4" P.V.C.  
(size) (material)  
(6) pump 34 12  
(HP) (yield gpm)

Electric  
(type power)  
(7) electric log (yes or no)

(organization running log)  
(8) how well bottom plugged Cap.


SEP 15 10 27

DRILLERS REMARKS:

MISSISSIPPI  
BOARD OF WATER COMMISSIONERS

If well telescopes please sketch and show depths.

GROUND LEVEL

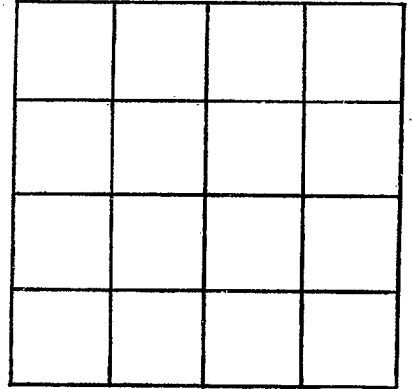

SECTION \_\_\_\_\_

Please indicate well location X.

ADDITIONAL INFORMATION

If more than one screen,  
show locations of each on sketch.