

Marshall

MISSISSIPPI  
BOARD OF WATER COMMISSIONERS  
416 North State Street  
Jackson, Mississippi 39201

WATER WELL DRILLERS LOG

**COPIED**

date well completed

19

firm name

county well located

LANDOWNER: Joe Bynum  
Beyala Miss.

description of formations encountered

from

to

(mailing address)

Red Clay  
Red sand  
white sand

0 27  
20 100  
100 140  
140

WELL LOCATION:

sec. 4 T 4 N R 5 E  
4 1/2 miles SE. of Weston  
(distance) (direction) (nearest town)

WELL PURPOSE:

(home, irrigation, municipal, industrial)

WELL COMPLETION DATA:

- (1) diameter (inches) 4"
- (2) total depth (feet) 140'
- (3) static water level (feet) 95' below top of ground.
- (4) casing P.V.C. (material) (depth) (size) if telescope see back.
- (5) screen 10' (length) 130 (depth to top) 4" (size) P.V.C. (material)
- (6) pump 3/4 (HP) 12 (yield gpm) elec. (type power)
- (7) electric log (yes or no)

**COPIED**

(organization running log)

(8) how well bottom plugged CP.


SEP 15 1971

DRILLERS REMARKS:

MISS. BD. OF  
WATER COMM.

If well telescopes please sketch and show depths.

GROUND LEVEL

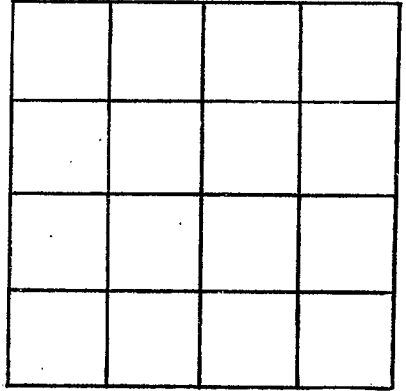

SECTION \_\_\_\_\_

Please indicate well location X.

ADDITIONAL INFORMATION

If more than one screen,  
show locations of each on sketch.