

Marshall

MISSISSIPPI BOARD OF WATER COMMISSIONERS

416 North State Street
Jackson, Mississippi 39201

WATER WELL DRILLERS LOG

Marshall
~~County~~

Atkinson & Feist

date well completed 19

firm name

county well located

LANDOWNER: *Jimmy Clark Jr*

description of formations encountered

from to

BH 3 Bogalin Mine

<i>Clay</i>	<i>0</i>	<i>20</i>
<i>Red sand</i>	<i>20</i>	<i>150</i>
<i>white clay</i>	<i>150</i>	<i>165</i>
<i>red sand</i>	<i>165</i>	<i>180</i>
		<i>180</i>

(mailing address)

WELL LOCATION:

sec. *4* T. *4* N. R. *5* E
6 miles *SE* of *W. Dean*
(distance) (direction) (nearest town)

WELL PURPOSE:

(home, irrigation, municipal, industrial)

WELL COMPLETION DATA:

- (1) diameter (inches) *4"*
- (2) total depth (feet) *180'*
- (3) static water level (feet) *135'* below above top of ground.
- (4) casing *PVC* *170*
(material) (depth)
(size) if telescope see back.
- (5) screen *10'* *170*
(length) (depth to top)
1/2" *PVC*
(size) (material)
- (6) pump *3/4 HP* *12*
(HP) (yield gpm)
Electric
(type power)
- (7) electric log (yes or no)
- (organization running log)
- (8) how well bottom plugged *cap*

COPIED


SEP 15 1971

DRILLERS REMARKS:

MISS. BD. OF
WATER COMMISSIONERS

If well telescopes please sketch and show depths.

GROUND LEVEL

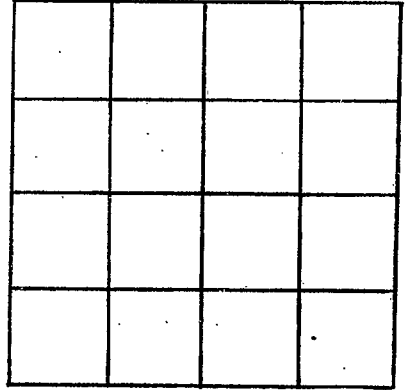

SECTION _____

Please indicate well location X.

ADDITIONAL INFORMATION

If more than one screen,
show locations of each on sketch.