

Marshall
N-24
E-71

MISSISSIPPI
BOARD OF WATER COMMISSIONERS
416 North State Street
Jackson, Mississippi 39201

WATER WELL DRILLERS LOG

CODED

Atkinson Frost Marshall

19 date well completed

firm name

county well located

LANDOWNER: *Amie B. Davis*

description of formations encountered

from

to

B#3 Bogalua Miss
(mailing address)

Clay

0 70

Sand

70 80

Blue Clay

80 100

sand + Blue Mined

100 120

white sand

120 140

WELL LOCATION:

sec. *4* T. *4* N. R. *4* E. *W*
4 1/2 miles *SE* of *Watson*
(distance) (direction) (nearest town)

WELL PURPOSE:

(home, irrigation, municipal, industrial)

WELL COMPLETION DATA:

- (1) diameter (inches) *6"*
(2) total depth (feet) *120*
(3) static water level (feet) *80* below above top of ground.

(4) casing *P.V.C. 140*
(material) (depth)

(size) if telescope see back.

(5) screen *10' 130'*
(length) (depth to top)

4" *P.V.C.*
(size) (material)

(6) pump *3/4* *12*
(HP) (yield gpm)

elec.
(type power)

(7) electric log (yes or no)

(organization running log)

(8) how well bottom plugged *CAP.*

CODED

SEP 15 1971


MISS. BD. OF

WATER COMMISSIONERS

DRILLERS REMARKS:

If well telescopes please sketch and show depths.

GROUND LEVEL

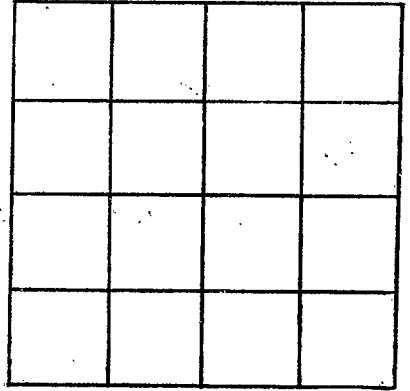

SECTION _____

Please indicate well location X.

ADDITIONAL INFORMATION

If more than one screen, show locations of each on sketch.