

MARSHALL
N 26
9-25-71

MISSISSIPPI
 BOARD OF WATER COMMISSIONERS
 416 North State Street
 Jackson, Mississippi 39201

WATER WELL DRILLERS LOG

Sept 25 - 1971 Earl Jones Well Co - Marshall
 date well completed firm name county well located

LANDOWNER:

Roy Morris

description of formations encountered

CODED

Holly Springs Miss. RT 3
 (mailing address)

<u>Topsoil</u>	<u>0</u>	<u>3</u>
<u>sand</u>	<u>3</u>	<u>18</u>
<u>clay</u>	<u>18</u>	<u>45</u>
<u>sand</u>	<u>25</u>	<u>85</u>
<u>clay</u>	<u>85</u>	<u>95</u>
<u>sand</u>	<u>95</u>	<u>154</u>

WELL LOCATION:

sec 2 T 4 N R 4 E
4 1/2 miles S of Red Bank
 (distance) (direction) (nearest town)

WELL PURPOSE: Home
 (home, irrigation, municipal, industrial)

WELL COMPLETION DATA:

- (1) diameter (inches) 2"
- (2) total depth (feet) 154
- (3) static water level (feet) 105 below above ground.
- (4) casing plastic 148'
 (material) (depth)
2"
 (size) if telescope see back.
- (5) screen 6' 148'
 (length) (depth to top)
2 plastic gravel
 (size) (material)
- (6) pump 3/4 3 1/2
 (HP) (yield gpm)
Electric
 (type power)
- (7) electric log no
 (yes or no)
- (organization running log)
- (8) how well bottom plugged plastic cap

CODED


OCT 6 - 1971

DRILLERS REMARKS:

MISS. BLDG. DEPT.
 WATER DIVISION

If well telescopes please sketch and show depths.

GROUND LEVEL

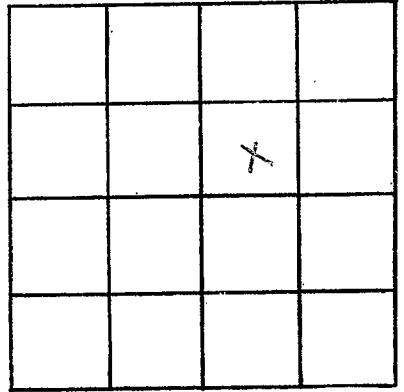

SECTION 2

Please indicate well location X.

ADDITIONAL INFORMATION

If more than one screen, show locations of each on sketch.