

Marshall  
 N 27  
 5-67

MISSISSIPPI  
 BOARD OF WATER COMMISSIONERS  
 416 North State Street  
 Jackson, Mississippi 39201

**CODED**

WATER WELL DRILLERS LOG

May 16 1967 R. L. Carpenter Marshall  
 date well completed firm name county well located

LANDOWNER: St. Hill Church  
 Marianna,  
 Miss  
 (mailing address)

description of formations encountered	from to	
	ft	ft
Surface Soil	0	6

WELL LOCATION:  
 sec. 21 T. 4 N R. 4 E  
 1 1/2 miles South of Marianna  
 (distance) (direction) (nearest town)

Coarse Red Sand	6	23
Coarse White sand	23	58

WELL PURPOSE: Church  
 (home, irrigation, municipal, industrial)


White Clay	58	61
------------	----	----

WELL COMPLETION DATA:

- (1) diameter (inches) 4 in
- (2) total depth (feet) 145
- (3) static water level (feet) 105 below top of ground.
- (4) casing Plastic, 139 (material) (depth)
- if telescope see back.
- (5) screen 6 ft. 139 (length) (depth to top)
- 4 in. Plastic + Gravel (size) (material)
- (6) pump 1/2 (HP) 10 (yield gpm)
- Electric (type power)
- (7) electric log No. (yes or no)
- (organization running log)
- (8) how well bottom plugged Plastic Plug

Med. White sand	61	75
White Clay	75	87
Blue mud	87	127
White Coarse sand	127	145

**CODED**

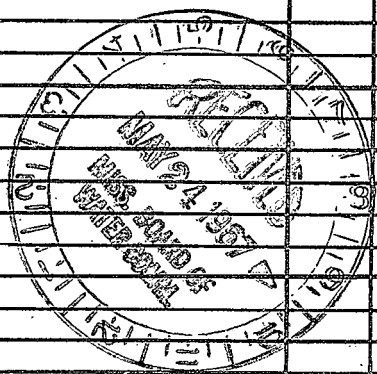


DRILLERS REMARKS:

If well telescopes please sketch and show depths.

GROUND LEVEL

R4W

T45

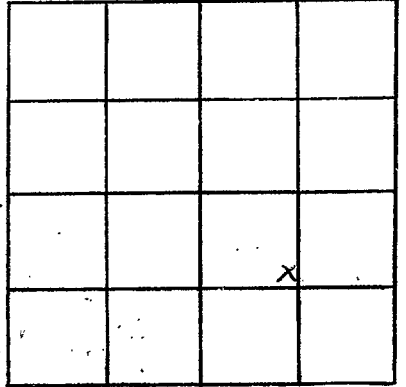

SECTION 27

Please indicate well location X.

ADDITIONAL INFORMATION

If more than one screen, show locations of each on sketch.