

clm for wpt 8/6/68
red book 8/26/68

Marshall
N 28
6-68

MISSISSIPPI
BOARD OF WATER COMMISSIONERS
416 North State Street
Jackson, Mississippi 39201

WATER WELL DRILLERS LOG

CODED

6-23 1968 date well completed
Bob Hill W & C firm name
Marshall county well located

LANDOWNER: Brown

description of formations encountered

	from	to
--	------	----

Byrdville, Miss.
(mailing address)

TOP soil
Red CLAY
WHITE SAND

	0	5
	5	40
	40	160

WELL LOCATION:

sec. 3 T 7 N R A E ?
10 miles South of Victoria
(distance) (direction) (nearest town)

WELL PURPOSE: Home
(home, irrigation, municipal, industrial)

WELL COMPLETION DATA:

- (1) diameter (inches) 4
- (2) total depth (feet) 160'
- (3) static water level (feet) 100 below above top of ground.
- (4) casing Plastic, 160'
(material) (depth)

(size) If telescope see back.

- (5) screen 20, 140'
(length) (depth to top)
- 4, Plastic
(size) (material)

- (6) pump 1/2, 10
(HP) (yield gpm)

Elec.
(type power)

- (7) electric log no
(yes or no)

(organization running log)

- (8) how well bottom plugged plugged

DRILLERS REMARKS:


good drilling

CODED

JUL 2 1968
MISS. BOARD OF
WATER COMMISSIONERS

If well telescopes please sketch and show depths.

GROUND LEVEL

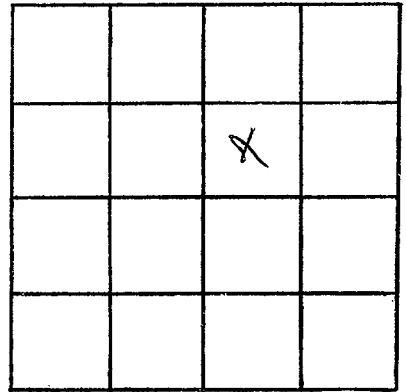

SECTION _____

Please indicate well location X.

ADDITIONAL INFORMATION

If more than one screen,
show locations of each on sketch.