

Marshall
N 29
7-68

MISSISSIPPI
BOARD OF WATER COMMISSIONERS
416 North State Street
Jackson, Mississippi 39201

CODED

WATER WELL DRILLERS LOG

July 16 1968 Empire Well Co Marshall
date well completed firm name county well located

LANDOWNER: Andrew Matthews
Byhalia, Miss.

description of fomations encountered	from	to
<u>Red Shaly Clay</u>	<u>6</u>	<u>30</u>
<u>Sand</u>	<u>30</u>	<u>160</u>

(mailing address)

WELL LOCATION:

sec. 8 T. 4 N. R. 4 E
3 miles N-E of Mayona
(distance) (direction) (nearest town)


WELL PURPOSE:

(home, irrigation, municipal, industrial)

WELL COMPLETION DATA:

- (1) diameter (inches) 4"
- (2) total depth (feet) 160
- (3) static water level (feet) 100 ^{below}/_{above} top of ground.
- (4) casing Plastic, 154 ft.
(material) (depth)
no if telescope see back.
(size)
- (5) screen 60 ft., 154 ft.
(length) (depth to top)
008, gravel wall
(size) (material)
- (6) pump 3/4 10 gal
(HP) (yield gpm)
Elect
(type power)
- (7) electric log (yes or no)
(organization running log)
- (8) how well bottom plugged plastic plug


CODED

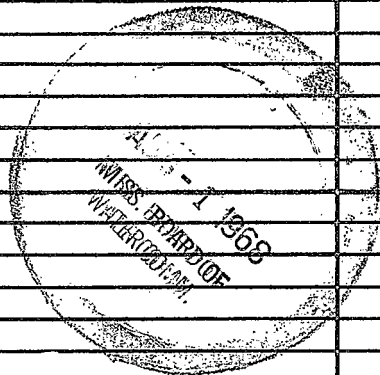

DRILLERS REMARKS:

If well telescopes please sketch and show depths.

GROUND LEVEL

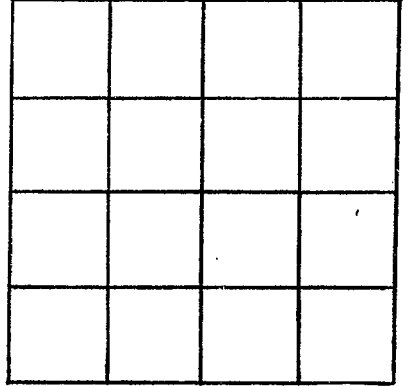

SECTION _____

Please indicate well location X.

ADDITIONAL INFORMATION

If more than one screen, show locations of each on sketch.