

CODED MISSISSIPPI

BOARD OF WATER COMMISSIONERS

416 North State Street

Jackson, Mississippi 39201

FEB 22 1972

MARSHALL  
N 30  
6-20-71

WATER WELL DRILLERS LOG

MISS. DD. 100


June 20 1971 R. L. Coyate Marshall  
date well completed firm name county well located

LANDOWNER:	description of formations encountered	from	to
L. C. Jones Holy Springs, Miss. R. FD (mailing address)	Surface Soil	0	21
	med. white sand	21	65
WELL LOCATION: sec. 27 T 4 N R 4 E (distance) miles (direction) of (nearest town)	white clay & fine white sand	65	150
WELL PURPOSE: Home (home, irrigation, municipal, industrial)	med white sand	150	193
WELL COMPLETION DATA: (1) diameter (inches) 4	white coarse sand	183	220
(2) total depth (feet) 220			
(3) static water level (feet) 168 below above top of ground.			
(4) casing Plastic, 214 Ft. (material) (depth)			
(size) if telescope see back.			
(5) screen 6 ft., 214 ft. (length) (depth to top)			
4 in. Plastic & Seamed (size) (material)			
(6) pump 3/4 10 (HP) (yield gpm)			
Elec. (type power)			
(7) electric log No (yes or no)			
(organization running log)			
(8) how well bottom plugged Plastic cap			
DRILLERS REMARKS:			

CODED

If well telescopes please sketch and show depths.

GROUND LEVEL

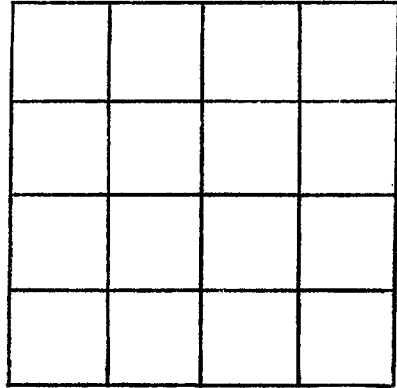

SECTION \_\_\_\_\_

Please indicate well location X.

ADDITIONAL INFORMATION

If more than one screen,  
show locations of each on sketch.