

MARSHALL

N 31

6-23-71

CODED MISSISSIPPI

BOARD OF WATER COMMISSIONERS

416 North State Street

Jackson, Mississippi 39201

FEB 22 1972

WATER WELL DRILLERS LOG

June 23 1971 R. L. Carpenter Marshall
date well completed firm name county well located


LANDOWNER: <i>Wash King Holy Springs, Miss. R. F. D.</i> (mailing address)	description of formations encountered	from	to
WELL LOCATION: sec. <i>34</i> T. <i>4</i> N. R. <i>4</i> E <i>2</i> miles <i>South</i> of <i>Wardona</i> (distance) (direction) (nearest town)	<i>Surface Soil</i>	<i>0</i>	<i>19</i>
WELL PURPOSE: <i>Home</i> (home, irrigation, municipal, industrial)	<i>med red sand</i>	<i>19</i>	<i>53</i>
WELL COMPLETION DATA: (1) diameter (inches) <i>4</i> (2) total depth (feet) <i>265</i> (3) static water level (feet) <i>165</i> below above top of ground. (4) casing <i>Plaster</i> , <i>199 ft.</i> (material) (depth) (size) if telescope see back. (5) screen <i>6 ft</i> , <i>199 ft.</i> (length) (depth to top) <i>1/2"</i> , <i>Plaster & Sand</i> (size) (material) (6) pump <i>3/4</i> , <i>10</i> (HP) (yield gpm) <i>Elec.</i> (type-power) (7) electric log <i>no</i> (yes or no) (organization running log) (8) how well bottom plugged <i>Plastic cap</i>	<i>med white sand</i>	<i>53</i>	<i>89</i>
	<i>white coarse sand</i>	<i>89</i>	<i>120</i>
	<i>white clay</i>	<i>120</i>	<i>143</i>
	<i>med d. size white sand</i>	<i>143</i>	<i>175</i>
	<i>white coarse sand</i>	<i>175</i>	<i>205</i>

CODED

DRILLERS REMARKS:

If well telescopes please sketch and show depths.

GROUND LEVEL

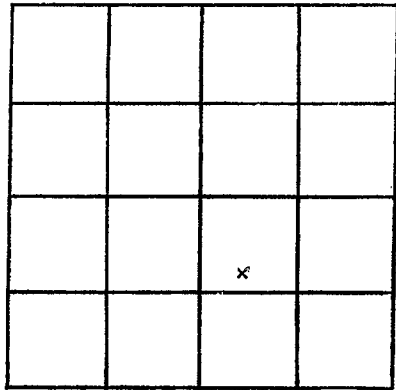

SECTION 34

Please indicate well location X.

ADDITIONAL INFORMATION

If more than one screen,
show locations of each on sketch.