

# CODED

MISSISSIPPI  
BOARD OF WATER COMMISSIONERS  
416 North State Street  
Jackson, Mississippi 39201

FEB 16 1972

**MARSHALL**  
**N32**  
**2-4-72**

**WATER WELL DRILLERS LOG**

*Clearmont, Mississippi*  
*Marshall*


2-4 1972      Clearmont      Marshall  
date well completed      firm name      county well located

LANDOWNER:	description of formations encountered	from	to
<u>Annie S. Pool</u>	<u>clay</u>	<u>0</u>	<u>20</u>
<u>Bethalia, miss</u> (mailing address)	<u>gravel</u>	<u>20</u>	<u>100</u>
WELL LOCATION: sec. <u>22</u> T <u>4</u> N <u>3</u> R <u>4</u> E <u>W</u>	<u>clay</u>	<u>100</u>	<u>130</u>
<u>2</u> miles <u>north</u> of <u>Morison</u> (distance) (direction) (nearest town)	<u>gravel</u>	<u>130</u>	<u>180</u>
WELL PURPOSE: <u>Drinking</u> (home, irrigation, municipal, industrial)			
WELL COMPLETION DATA:			
(1) diameter (inches) <u>4"</u>			
(2) total depth (feet) <u>180 feet</u>			
(3) static water level (feet) <u>120</u> below above top of ground.			
(4) casing <u>pvc</u> , <u>180 feet</u> (material) (depth)			
(size) if telescope see back.			
(5) screen <u>GH</u> , <u>124 feet</u> (length) (depth to top)			
<u>4"</u> , <u>gravel wash</u> (size) (material)			
(6) pump <u>3/4</u> <u>12</u> (HP) (yield gpm)			
(type power)			
(7) electric log <u>Elect</u> (yes or no)			
(organization running log)			
(8) how well bottom plugged <u>4" pvc</u>			
DRILLERS REMARKS: <u>60 feet water</u>			

**CODED**

If well telescopes please sketch and show depths.

GROUND LEVEL

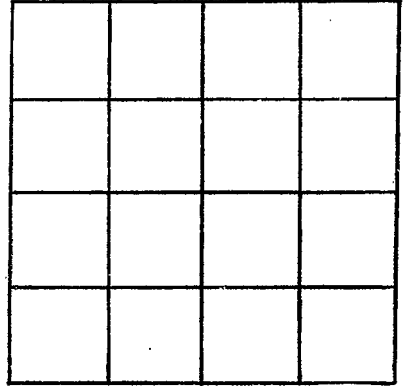

SECTION \_\_\_\_\_

Please indicate well location X.

ADDITIONAL INFORMATION

If more than one screen,  
show locations of each on sketch.