

MARSHALL
N 33
2-3-72

MISSISSIPPI
 BOARD OF WATER COMMISSIONERS
 416 North State Street
 Jackson, Mississippi 39201
WATER WELL DRILLERS LOG

CODED

Feb 3 1972 date well completed
 Earl Jones Well Co firm name
 Marshall county well located

LANDOWNER:
 Buster Thompson
 Victoria Miss
 (mailing address)

WELL LOCATION:
 sec. 3 T 4 N R 4 E
 in miles of Victoria
 (distance) (direction) (nearest town)

description of formations encountered	from	to
Topsoil - clay	0	18
sand	18	70
clay	70	80
sand	80	115
clay	115	130
sand	130	135

WELL PURPOSE: Home
 (home, irrigation, municipal, industrial)

WELL COMPLETION DATA:

(1) diameter (inches) 2"

(2) total depth (feet) 145

(3) static water level (feet) 80 below top of ground.

(4) casing Plastic 139 (material) (depth)
 2" (size) if telescope see back.

(5) screen 6' 139 (length) (depth to top)
 2" Plastic Filter pack (size) (material)

(6) pump 1 5 (HP) (yield gpm)
 Electric (type power)

(7) electric log no (yes or no)

(organization running log)

(8) how well bottom plugged Plastic cap

CODED


DRILLERS REMARKS:

FFB 28 1972

MISS. BD. OF
 WATER COM.

If well telescopes please sketch and show depths.

GROUND LEVEL

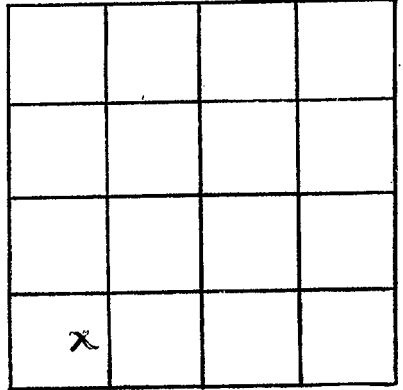

SECTION 3

Please indicate well location X.

ADDITIONAL INFORMATION

If more than one screen,
show locations of each on sketch.