

MARSHALL
N35
4-72

MISSISSIPPI
 BOARD OF WATER COMMISSIONERS
 416 North State Street
 Jackson, Mississippi 39201

CODED

WATER WELL DRILLERS LOG

Atkins & Frick *Marshall*

19 date well completed firm name county well located

LANDOWNER:
Fred W. Ralston
Rally Springs
 (mailing address)

description of formations encountered	from	to
<i>Clay</i>	<i>0</i>	<i>18</i>
<i>sand</i>	<i>18</i>	<i>50</i>
<i>white clay</i>	<i>50</i>	<i>100</i>
<i>white sand</i>	<i>100</i>	<i>180</i>

WELL LOCATION:
 sec. 4 T 4 N R. 4 E
6 miles SW of Rally Springs
 (distance) (direction) (nearest town)

WELL PURPOSE: Drinking
 (home, irrigation, municipal, industrial)

- WELL COMPLETION DATA:
- (1) diameter (inches) 4"
 - (2) total depth (feet) 180
 - (3) static water level (feet) 140 below top of ground.
 - (4) casing P.V.C.
 (material) (depth)
 - (size) if telescope see back.
 - (5) screen 10 FT
 (length) (depth to top)
 - (size) (material)
 - (6) pump 3/4 10
 (HP) (yield gpm)
 - Elec
 (type power)
 - (7) electric log NO
 (yes or no)

CODED

APR 12 1972

MISS. BU. OF WATER COMM.


(organization running log)

(8) how well bottom plugged CAP.

DRILLERS REMARKS:

If well telescopes please sketch and show depths.

GROUND LEVEL

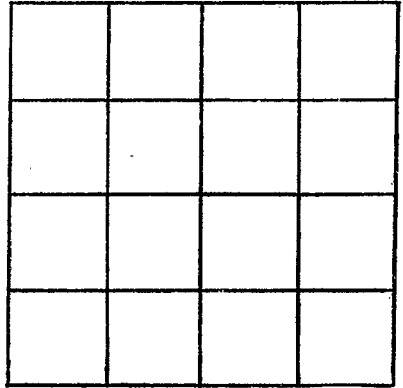

SECTION _____

Please indicate well location X.

ADDITIONAL INFORMATION

If more than one screen, show locations of each on sketch.