

MARSHALL
N 38
7-72

MISSISSIPPI
 BOARD OF WATER COMMISSIONERS
 416 North State Street
 Jackson, Mississippi 39201

CODED

WATER WELL DRILLERS LOG

Atkinson Fast Marshall

date well completed _____ 19 _____ firm name _____ county well located _____

LANDOWNER: *Victory Homes*

Description of formations encountered

from to

Bygdin Miss
 (mailing address)

<i>clay</i>	0	10
<i>sand</i>	10	30
<i>white sand</i>	30	80

WELL LOCATION:

sec. ~~4~~ T ~~4~~ N R ~~4~~ E
 8 miles S of *Bygdin*
 (distance) (direction) (nearest town)

WELL PURPOSE: *home*
 (home, irrigation, municipal, industrial)

WELL COMPLETION DATA:

- (1) diameter (inches) 4"
- (2) total depth (feet) 80
- (3) static water level (feet) 30 below top of ground.
- (4) casing PVC (material), _____ (depth)
 _____ (size) If telescope see back.
- (5) screen 5ft (length), 7.5 (depth to top)
4" (size), PVC (material)
- (6) pump 1/2 (HP), 10 (yield gpm)
elec (type power)
- (7) electric log _____ (yes or no)

 (organization running log)

(8) how well bottom plugged CAP


CODED

JUL 12 1972

DRILLERS REMARKS:

If well telescopes please sketch and show depths.

GROUND LEVEL

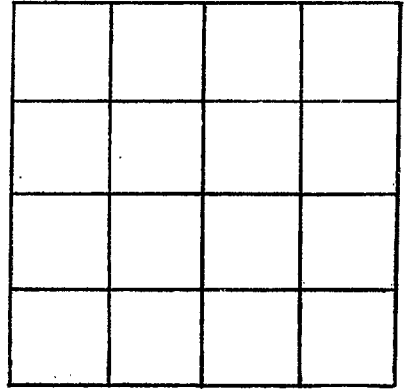

SECTION _____

Please indicate well location X.

ADDITIONAL INFORMATION

If more than one screen, show locations of each on sketch.