

~~LOCATION~~

MARSHALL
N 40
5-28-73

MISSISSIPPI
BOARD OF WATER COMMISSIONERS
416 North State Street
Jackson, Mississippi 39201

CODED

WATER WELL DRILLERS LOG

5-28-73 19 Atkinson & Feun Mississippi
date well completed firm name county well located

LANDOWNER:
Walter Dockey
Beulah Miss
(mailing address)

description of formations encountered	from	to
	<u>clay</u>	<u>0</u>
<u>white sand</u>	<u>15</u>	<u>110</u>

WELL LOCATION:
sec. 4 T. 4 N. R. 4 E
5 miles SE of Watson
(distance) (direction) (nearest town)

WELL PURPOSE: home
(home, irrigation, municipal, industrial)

- WELL COMPLETION DATA:
- (1) diameter (inches) 4"
 - (2) total depth (feet) 110
 - (3) static water level (feet) 62' below above top of ground.
 - (4) casing P.V.C. 100
(material) (depth)
(size) if telescope see back.
 - (5) screen 10 100
(length) (depth to top)
4" P.V.C.
(size) (material)
 - (6) pump 1/2 10
(HP) (yield gpm)
Electric
(type power)
 - (7) electric log NO
(yes or no)
(organization running log)
 - (8) how well bottom plugged CAP.

CODED


DRILLERS REMARKS:

JUN 6 1973

30 OF
WATER COM.

If well telescopes please
sketch and show depths.

GROUND LEVEL

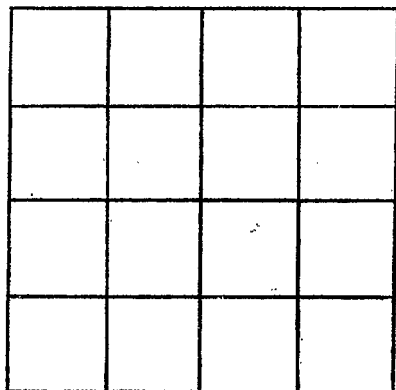

SECTION _____

Please indicate well location X.

ADDITIONAL INFORMATION

If more than one screen,
show locations of each on sketch.