

MARSHALL
 N 41
 9-19-73

MISSISSIPPI
 BOARD OF WATER COMMISSIONERS
 416 North State Street
 Jackson, Mississippi 39201

CODED

WATER WELL DRILLERS LOG

SEPT 19 1973 Billy R. Simpson MARSHALL
 date well completed firm name county well located

LANDOWNER:
KITTIE B. REYNOLDS
BYHALIA MISS.
 (mailing address)

description of formations encountered	from	to
<u>SURFACE CLAY</u>	<u>0</u>	<u>16</u>
<u>COARSE SAND</u>	<u>16</u>	<u>158</u>

WELL LOCATION:
 sec. 2 T 4 N R 4 E
5 miles S of RED BANKS
 (distance) (direction) (nearest town)

WELL PURPOSE: HOME
 (home, irrigation, municipal, industrial)

- WELL COMPLETION DATA:
- (1) diameter (inches) 4
 - (2) total depth (feet) 154
 - (3) static water level (feet) 97 below above top of ground.
 - (4) casing PVC 148
 (material) (depth)
 _____ if telescope see back.
 (size)
 - (5) screen 6" 148
 (length) (depth to top)
4" PVC
 (size) (material)
 - (6) pump 3/4 10
 (HP) (yield gpm)
ELEC
 (type power)
 - (7) electric log NO
 (yes or no)
 - (organization running log) _____
 - (8) how well bottom plugged PVC
CAP

CODED


SEP 24 1973

MISS. RD. OF
 WATER COM.

DRILLERS REMARKS:

If well telescopes please sketch and show depths.

GROUND LEVEL

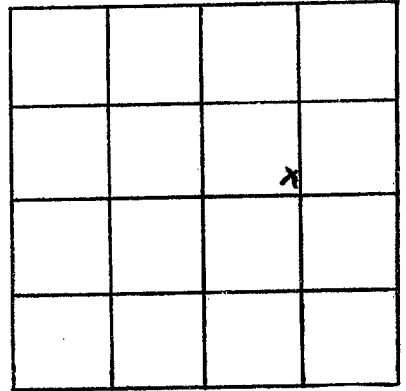

SECTION 2

Please indicate well location X.

ADDITIONAL INFORMATION

If more than one screen, show locations of each on sketch.