

MARSHALL
N 42
11-9-73

MISSISSIPPI
BOARD OF WATER COMMISSIONERS
416 North State Street
Jackson, Mississippi 39201

WATER WELL DRILLERS LOG

11-9 1973 *Dean Kent Druffell* *Marshall*
date well completed firm name county well located

LANDOWNER:

Phillip Underwood
Holly Springs, Miss
(mailing address)

description of formations encountered

clay
Sand

from to
0 20
20 170

WELL LOCATION:

sec. 27 T 4 N R 4 E
18 miles South of Holly Springs
(distance) (direction) (nearest town)

WELL PURPOSE: *Drinking*
(home, irrigation, municipal, industrial)

WELL COMPLETION DATA:

- (1) diameter (inches) 4"
- (2) total depth (feet) 170 feet
- (3) static water level (feet) 120 ^{blow} above top of ground.
- (4) casing PVC 170 feet
(material) (depth)
(size) if telescope see back.
- (5) screen 7ft. 163 feet
(length) (depth to top)
4" Gravel wall
(size) (material)
- (6) pump 3/4 14
(HP) (yield gpm)
(type power)
- (7) electric log Elect.
(yes or no)
(organization running log)
- (8) how well bottom plugged 4" cap.

CODED


DRILLERS REMARKS:

DEC 13 1973

MISS. Bd. OF
WATER COMMISSIONERS

If well telescopes please sketch and show depths.

GROUND LEVEL

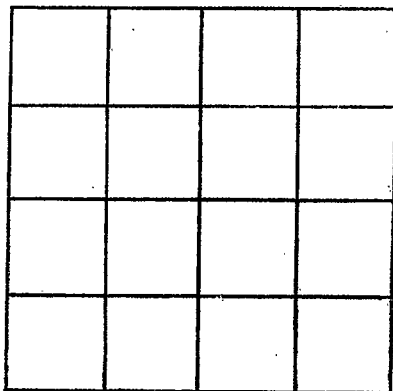

SECTION _____

Please indicate well location X.

ADDITIONAL INFORMATION

If more than one screen,
show locations of each on sketch.