

MARSHALL

N 44

8-31-73

MISSISSIPPI BOARD OF WATER COMMISSIONERS
416 North State Street
Jackson, Mississippi 39201

CODED

WATER WELL DRILLERS LOG

Aug. 31 1973
date well completed

R. L. Carpenter
firm name

Marshall
county well located

LANDOWNER: <u>Willie Jones</u>	description of formations encountered	from	to
<u>Prichard, Miss</u> <u>RFD</u> (mailing address)			
	<u>Surface Soil</u>	<u>0</u>	<u>15</u>
	<u>Med. Red Sand</u>	<u>15</u>	<u>40</u>
	<u>White Clay</u>	<u>45</u>	<u>47</u>
	<u>Fine White Sand</u>	<u>47</u>	<u>183</u>
	<u>White Clay</u>	<u>103</u>	<u>115</u>
	<u>White Coarse Sand</u>	<u>115</u>	<u>185</u>

WELL LOCATION:

sec 27 T 4 N R 4 E
 (distance) (direction) (nearest town)
1 miles South of Prichard

WELL PURPOSE: Home
(home, irrigation, municipal, industrial)

WELL COMPLETION DATA:


- (1) diameter (inches) 4
- (2) total depth (feet) 185
- (3) static water level (feet) 118 below above top of ground.
- (4) casing Plastic, 179 ft.
(material) (depth)
If telescope see back.
(size)
- (5) screen 6 ft., 179 ft.
(length) (depth to top)
4 in., Plastic & Strand
(size) (material)
- (6) pump 1/2 8
(HP) (yield gpm)
Elec.
(type power)
- (7) electric log No.
(yes or no)

CODED

(organization running log)

(8) how well bottom plugged Plastic Clay

DRILLERS REMARKS:

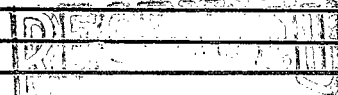

MAR 12 1974

If well telescopes please
sketch and show depths.

GROUND LEVEL

X			

SECTION 27

Please indicate well location X.

ADDITIONAL INFORMATION

If more than one screen,
show locations of each on sketch.