

MARSHALL
N 45
10-21-73

MISSISSIPPI
 BOARD OF WATER COMMISSIONERS
 416 North State Street
 Jackson, Mississippi 39201

CODED

WATER WELL DRILLERS LOG

Oct. 21 1973 R. L. Carpenter Marshall
 date well completed firm name county well located

LANDOWNER: <u>Louis McKinney</u> <u>Monrovia, Miss</u>	description of formations encountered	from	to
<u>RFD</u> (mailing address)	<u>Surface Soil</u>	<u>0</u>	<u>18</u>
WELL LOCATION: sec. <u>27</u> T. <u>4</u> N R. <u>4</u> E <u>2</u> miles <u>south</u> of <u>Monrovia</u> (distance) (direction) (nearest town)	<u>Med. Coarse white Sand</u>	<u>18</u>	<u>53</u>
WELL PURPOSE: <u>Home</u> (home, irrigation, municipal, industrial)	<u>white Fine Sand & Clay</u>	<u>53</u>	<u>78</u>
WELL COMPLETION DATA:	<u>white Med. Sand</u>	<u>78</u>	<u>120</u>
(1) diameter (inches) <u>4</u>	<u>white Clay</u>	<u>120</u>	<u>150</u>
(2) total depth (feet) <u>190</u>	<u>Med. white Sand</u>	<u>150</u>	<u>190</u>
(3) static water level (feet) <u>100</u> below top of ground.			
(4) casing <u>Plastic</u> (material), <u>184 ft.</u> (depth)			
<u> </u> (size) if telescope see back.			
(5) screen <u>4 ft.</u> (length), <u>184 ft.</u> (depth to top)			
<u>4 in.</u> (size), <u>Plastic & Sand</u> (material)			
(6) pump <u>1/2</u> (HP), <u>8</u> (yield gpm)			
<u>Elec.</u> (type power)			
(7) electric log <u>No.</u> (yes or no)			
<u> </u> (organization running log)			
(8) how well bottom plugged <u>Plastic Plug</u>			
DRILLERS REMARKS:			


CODED

RECORDED
 INDEXED
 MAR 22 1974

MISS. Bd. OF WATER COMM

If well telescopes please sketch and show depths.

GROUND LEVEL

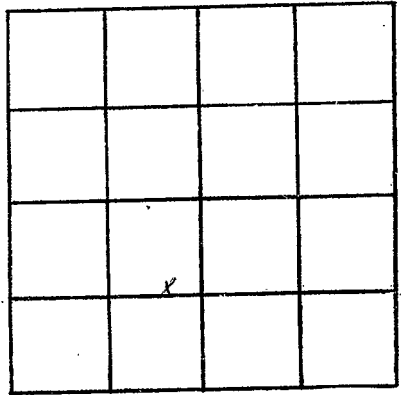

SECTION 27

Please indicate well location X.

ADDITIONAL INFORMATION

If more than one screen,
show locations of each on sketch.