

MARSHALL
N 49
7-8-74

MISSISSIPPI
BOARD OF WATER COMMISSIONERS
416 North State Street
Jackson, Mississippi 39201

CODE

WATER WELL DRILLERS LOG

July 8 1974 Dent Ket Buford Marshall
date well completed firm name county well located

LANDOWNER:
Mr. James M. Farber
Bogalusa, Miss.
(mailing address)

description of formations encountered	from	to
clay	0	10
sand	10	120
clay	120	140
sand	140	150

WELL LOCATION:
sec. 2 T. 4 N. R. 4 E.
4 miles South of Victoria
(distance) (direction) (nearest town)

WELL PURPOSE: Dwelling
(home, irrigation, municipal, industrial)

WELL COMPLETION DATA:

(1) diameter (inches) 4"

(2) total depth (feet) 150 feet

(3) static water level (feet) 80 below above top of ground.

(4) casing PVC 150 feet (material) (depth)
if telescope see back.

(5) screen 7 ft. 143 feet (length) (depth to top)
4" gravel wash (size) (material)

(6) pump 3/4 (HP) 14 (yield gpm)
(type power)

(7) electric log none (yes or no)
(organization running log)

(8) how well bottom plugged 4" cap.


CODE U

DECEMBER 1974
AUG - 9 1974

DRILLERS REMARKS:

If well telescopes please sketch and show depths.

GROUND LEVEL

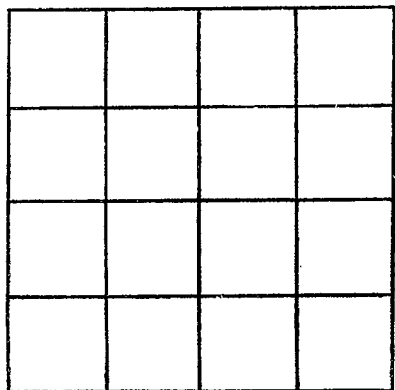

SECTION _____

Please indicate well location X.

ADDITIONAL INFORMATION

If more than one screen,
show locations of each on sketch.