

MARSHALL
~~7-50~~ N 51
 7-20-74

MISSISSIPPI
 BOARD OF WATER COMMISSIONERS
 416 North State Street
 Jackson, Mississippi 39201

CODED

WATER WELL DRILLERS LOG

7-20-74 date well completed W.A. Mason firm name Marshall county well located

LANDOWNER:
 James Hoover
 Memphis Tennessee
 (mailing address)

description of formations encountered	from	to
Clay Lint	0	15
Red sand	15	50
white sand	50	195


WELL LOCATION:
 sec. 31 T 4 N 4 E
 1 1/2 miles South of Orion
 (distance) (direction) (nearest town)

WELL PURPOSE: Home
 (home, irrigation, municipal, industrial)

- WELL COMPLETION DATA:
- (1) diameter (inches) 4"
 - (2) total depth (feet) 195'
 - (3) static water level (feet) 162' below top of ground.
 - (4) casing Plastic, 175' (material) (depth)
 4" (size) if telescope see back.
 - (5) screen 20', 175' (length) (depth to top)
 4" Plastic (size) (material)
 - (6) pump 3/4 HP, 7 (yield gpm)
 electric (type power)
 - (7) electric log No (yes or no)

(organization running log)
 (8) how well bottom plugged cap

DRILLERS REMARKS:

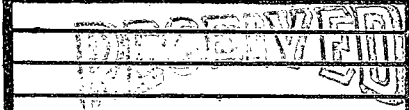


DEC 27 1974

MISS. BD. OF WATER COMMISSIONERS

If well telescopes please sketch and show depths.

GROUND LEVEL

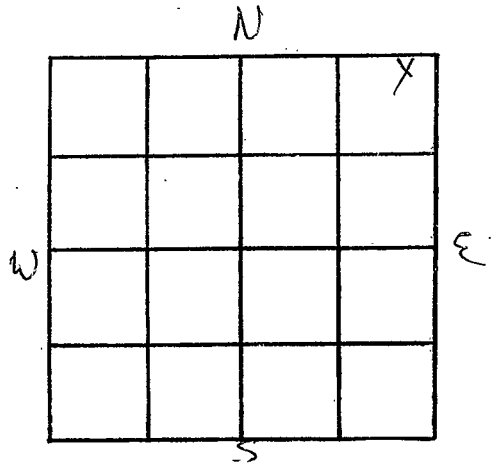

SECTION 31

Please indicate well location X.

ADDITIONAL INFORMATION

If more than one screen, show locations of each on sketch.