

MARSHALL
~~MISSISSIPPI~~ N 52
 5-29-74

MISSISSIPPI
 BOARD OF WATER COMMISSIONERS
 416 North State Street
 Jackson, Mississippi 39201

CODED

WATER WELL DRILLERS LOG

5-24-74 date well completed W.A. Mason firm name Marshall county well located

LANDOWNER:	description of formations encountered	from	to
James J. Uselton Southaven Miss. (mailing address)			
WELL LOCATION: sec. 31 T. 4 N. R. 4 E 1 1/2 miles South of Orion (distance) (direction) (nearest town)	Red sand	7	50
WELL PURPOSE: <u>Domestic</u> (home, irrigation, municipal, industrial)	white sand	50	135
WELL COMPLETION DATA: (1) diameter (inches) <u>4"</u> (2) total depth (feet) <u>135'</u> (3) static water level (feet) <u>90'</u> below top of ground. (4) casing <u>Plaster</u> , <u>125'</u> (material) (depth) <u>4"</u> if telescope see back. (size) (5) screen <u>10'</u> , <u>125'</u> (length) (depth to top) <u>4"</u> , <u>Plaster</u> (size) (material) (6) pump <u>1/2</u> , <u>7</u> (HP) (yield gpm) <u>electric</u> (type power) (7) electric log <u>No</u> (yes or no) (organization running log) (8) how well bottom plugged <u>Cap</u>			
DRILLERS REMARKS:			

CODED


RECEIVED
 MISSISSIPPI
 BOARD OF WATER COMMISSIONERS

DEC 27 1974

MISS. BD. OF WATER COMMISSIONERS

If well telescopes please sketch and show depths.

GROUND LEVEL

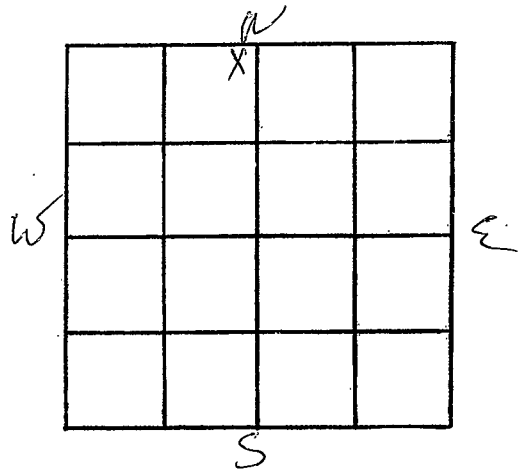

SECTION 31

Please indicate well location X.

ADDITIONAL INFORMATION

If more than one screen, show locations of each on sketch.