

**MARSHALL**  
~~53~~  
 4-30-74

MISSISSIPPI  
 BOARD OF WATER COMMISSIONERS  
 416 North State Street  
 Jackson, Mississippi 39201

CODED

WATER WELL DRILLERS LOG

4-30-1974 date well completed      W.A. Mason firm name      Marshall county well located

LANDOWNER:	description of formations encountered	from	to			
Joe Catledge RFD, Holly Springs, Miss. (mailing address)	Clay Lert	40	4			
WELL LOCATION: sec. 32 T. 4 N. R. 4 E. 3 1/2 miles SW of Maricopa (distance) (direction) (nearest town)	Red sand	4	50			
WELL PURPOSE: Home (home, irrigation, municipal, industrial)	white sand	50	130			
WELL COMPLETION DATA:	CODED					
(1) diameter (inches) 4"						
(2) total depth (feet) 130'						
(3) static water level (feet) 90' below top of ground.						
(4) casing Plastic, 120' (material) (depth) 4" (size) If telescope see back.						
(5) screen 10' - 120' (length) (depth to top)						
4" Plastic (size) (material)						
(6) pump 1/2 7 (HP) (yield gpm)						
electric (type power)						
(7) electric log No (yes or no)						
(organization running log)						
(8) how well bottom plugged cap						
DRILLERS REMARKS:						


RECEIVED

DEC 27 1974

MISS. DD. OF WATER COMM

If well telescopes please sketch and show depths.

GROUND LEVEL

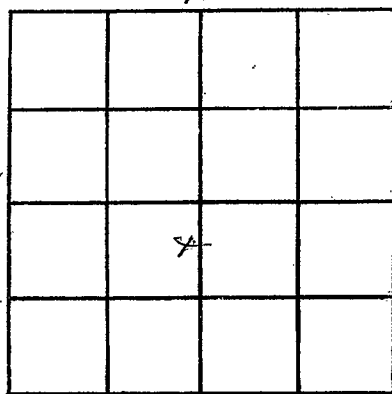

SECTION 32

Please indicate well location X.

ADDITIONAL INFORMATION

If more than one screen, show locations of each on sketch.