

MARSHALL

~~MISS~~ 159

3-16-79

MISSISSIPPI  
BOARD OF WATER COMMISSIONERS  
416 North State Street  
Jackson, Mississippi 39201

CODED

WATER WELL DRILLERS LOG

3-16-1979  
date well completed

W.A. Mason  
firm name

Marshall  
county well located

LANDOWNER:  
Marl Goy  
RFD, Byhalia Miss.  
(mailing address)

description of formations encountered	from	to
clay silt	0	70
Red sand	70	50
white sand	50	133

WELL LOCATION:  
sec. 31 T. 4 N. R. 4 E  
1 1/2 miles South of Osmon  
(distance) (direction) (nearest town)

WELL PURPOSE: Home  
(home, irrigation, municipal, industrial)

- WELL COMPLETION DATA:
- (1) diameter (inches) 4"
  - (2) total depth (feet) 133'
  - (3) static water level (feet) 90' below top of ground.
  - (4) casing Plast, 123' (material) (depth)  
4" (size) if telescope see back.
  - (5) screen 10' 123' (length) (depth to top)  
4" (size) Plastu (material)
  - (6) pump 1/2 7 (HP) (yield gpm)  
electru (type power)
  - (7) electric log No (yes or no)  
(organization running log)
  - (8) how well bottom plugged Cap

CODED

RECEIVED


DEC 27 1974

DRILLERS REMARKS:

MISS. BD. OF WATER COMM

If well telescopes please sketch and show depths.

GROUND LEVEL

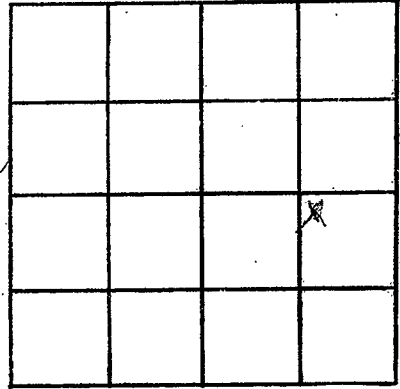

SECTION 31

Please indicate well location X.

ADDITIONAL INFORMATION

If more than one screen, show locations of each on sketch.