

MARSHALL
~~MISSISSIPPI~~
2-20-74

MISSISSIPPI
BOARD OF WATER COMMISSIONERS
416 North State Street
Jackson, Mississippi 39201

CODED

WATER WELL DRILLERS LOG

2-20-1974 W. G. Mason Marshall
date well completed firm name county well located

LANDOWNER:
Francis Henley
RFD, Byhalia Miss.
(mailing address)

description of formations encountered	from	to
clay silt	0	12
Red sand	12	30
white sand	30	205

WELL LOCATION:
sec. 3/T 4 N R. 4 E
1 1/2 miles south of Orion
(distance) (direction) (nearest town)

WELL PURPOSE:
(home, irrigation, municipal, industrial)

- WELL COMPLETION DATA:
- (1) diameter (inches) 4
 - (2) total depth (feet) 205
 - (3) static water level (feet) 113 below top of ground.
 - (4) casing Plastic, 190' (material) (depth)
4" (size) if telescope see back.
 - (5) screen 15 190' (length) (depth to top)
4" Plastic (size) (material)
 - (6) pump 3/4 15 (HP) (yield gpm)
electric (type power)
 - (7) electric log No (yes or no)

(organization running log)
(8) how well bottom plugged cap


DRILLERS REMARKS:

CODE

RECEIVED
DEC 27 1974
MISS. BD. OF WATER COMMISSIONERS

If well telescopes please sketch and show depths.

GROUND LEVEL

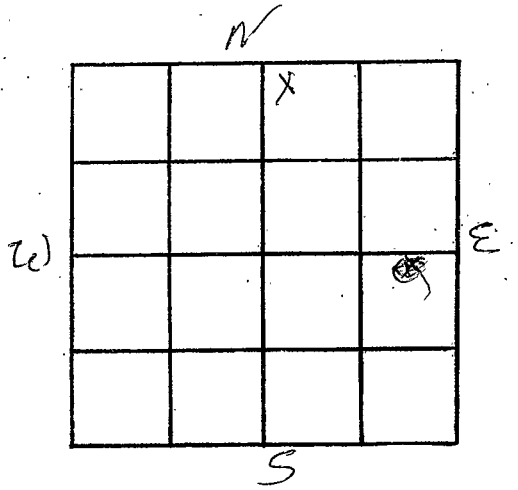

SECTION 31

Please indicate well location X.

ADDITIONAL INFORMATION

If more than one screen,
show locations of each on sketch.