

Marshall
 N 57
 6-9-75

MISSISSIPPI
 BOARD OF WATER COMMISSIONERS
 416 North State Street
 Jackson, Mississippi 39201

8

WATER WELL DRILLERS LOG

6-9-75 date well completed
 Gibbs Well Co. firm name
 Marshall county well located

LANDOWNER:	description of formations encountered	from	to
(mailing address)			
John T. Taylor Route 3	Red Clay	0	15
Harry Springs, Miss.	white clay	15	30
WELL LOCATION: sec 17 T 4 N R 4 E 15E 4 miles N of Maricanna	white clay	30	60
(distance) (direction) (nearest town)	white clay + sand	60	90
WELL PURPOSE: none (home, irrigation, municipal, industrial)	white sand	90	140
WELL COMPLETION DATA:			
(1) diameter (inches) 4 1/2			
(2) total depth (feet) 140			
(3) static water level (feet) 120 below top of ground			
(4) casing Plastic 140 (material) (depth)			
(size) if telescope see back.			
(5) screen 4 ft 136 (length) (depth to top)			
4 1/2 in. Screen (size) (material)			
(6) pump 1/2 10 (HP) (yield gpm)			
Electric 320 (type power)			
(7) electric log 40 (yes or no)			
(organization running log)			
(8) how well bottom plugged Cap			
DRILLERS REMARKS:			


CODED

MISS. BOARD OF WATER COMMISSIONERS
 JUN 21 1975

MISS. BD. OF WATER COMMISSIONERS

If well telescopes please sketch and show depths.

GROUND LEVEL

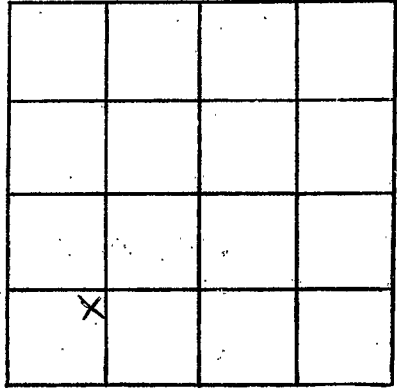

SECTION 17

Please indicate well location X.

ADDITIONAL INFORMATION

If more than one screen, show locations of each on sketch.