

Marshall
 N 58
 6-19-75

MISSISSIPPI
 BOARD OF WATER COMMISSIONERS
 416 North State Street
 Jackson, Mississippi 39201

CODED

WATER WELL DRILLERS LOG

6-19-75 1975 Hubbs Well Co. Marshall
 date well completed firm name county well located


LANDOWNER:	description of formations encountered	from	to
(mailing address)			
<u>Willie Lee Pool</u>	<u>Red Clay</u>	<u>0</u>	<u>15</u>
<u>Pt 3 Box 58A, Holly Springs, Miss</u>	<u>Black clay</u>	<u>15</u>	<u>60</u>
WELL LOCATION: sec <u>36</u> T <u>4</u> N R <u>4</u> E 15E <u>3</u> miles <u>Ne</u> of <u>Palma</u> (distance) (direction) (nearest town)	<u>Black clay + white sand</u>	<u>60</u>	<u>75</u>
WELL PURPOSE: <u>Home</u> (home, irrigation, municipal, industrial)	<u>white sand</u>	<u>75</u>	<u>220</u>
WELL COMPLETION DATA: (1) diameter (inches) <u>4 1/2</u> (2) total depth (feet) <u>220</u> (3) static water level (feet) <u>190</u> below top of ground. (4) casing <u>Plastic, 2 1/2</u> , (material) (depth) (size) if telescope see back. (5) screen <u>4 1/2</u> , <u>2 1/4</u> (length) (depth to top) <u>4 1/2</u> , <u>Gravel</u> (size) (material) (6) pump <u>1/2</u> <u>10</u> (HP) (yield gpm) <u>Electric 220</u> (type power) (7) electric log <u>no</u> (yes or no) (organization running log) (8) how well bottom plugged <u>Cap</u>			
DRILLERS REMARKS:			

RECEIVED
 JUL 21 1975

MISS. BD. OF WATER COMMISSIONERS

If well telescopes please sketch and show depths.

GROUND LEVEL

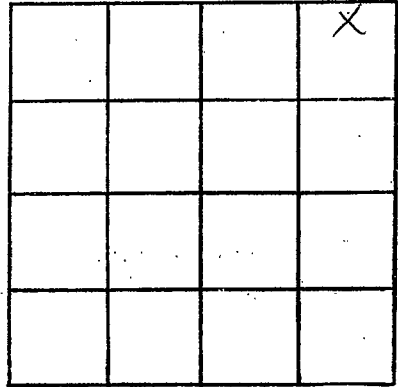

SECTION 76

Please indicate well location X.

ADDITIONAL INFORMATION

If more than one screen, show locations of each on sketch.