ounty: Marshall	Part 1 – Driller's Log	For Office Use Only:
ermit #:	Mississippi Department of Environmental Quality Office of Land and Water Resources P.O. Box 10631 Jackson, MS 39289-0631 (601)961-5210	Aquifer: Well #: & & & & & & & & & & & & & & &
- 19/102-00-7-	(601)354-6938 (fax)	E-log #:

Information on Well Owner	Well or Borehole Location
(Landowner if borehole is not for a water well)	
Owner Name Homes Sweet Holmes	Latitude: $34 \cdot 42 \cdot 854$ "Longitude: $89 \cdot 38 \cdot 501$ "
Mailing Address: LOT 50 MOLIANNA CO	Method of Lat/Long (circle one): Conventional Survey,
	USGS quad, (Hand-held GPS,) Survey-grade GPS
R + 1: 2 St +	NW 14 NE 1/ Sec 29 Twn 45 Rng YW
Byholia ms 38611 City State Zip Code	Distance Direction Nearest Town
Telephone No. (161) 488 - 2397	112 Miles E of Orion
Woll / Dave	hale Deste
Weil / Bore	
Date drilling started: $\frac{11-10-06}{100}$ Date drilling completed: $\frac{11-10-10}{100}$	OC Hole depth: $155^{\circ}$ Hole diameter: $6314^{\circ}$
Location of the source of any surface water used for drilling:	A
Method of dosing and volume of Chlorine used in drilling and devel	opment:A
Logs run (circle all applicable). No log run Electric Gamma Ray Name of organization running log(s):	Density Sonic Neutron Other:
Purpose of borehole (check one): Water WellGeotechnical/Geolo	ogical Investigation Ground Source Heat Pump
Seismic SurveyOther ( <i>describe</i> )	)
If drilling is not related to water well construction	
Purpose of Well (check one): Home / Industrial Public Supply	
If a flowing well, method of flow regulation: Valve $\underline{\nu} \dot{A}$ Ot	her (describe)
Static Water Level: feet above of below (circle one) la	and surface Date measured: 11715-06
Method of Measurement (circle one) steel tape electric tape	
Well depth: $155$ Well grouted to a depth of $100$ feet Type	
Casing length: 145 feet Casing diameter:	_inches Type of casing:
Screen length: <u>is</u> feet Screen diameter: <u>4</u>	_inches Type of screen:
Screen slot size:, OIOinches Setting depth: From	145 feet to 155 feet
Type of completion (circle all applicable): Gravel packed Underro	camed Telescoped Open hole Natural Development
Other (describe):	4
Top of lap pipe or reduction in casing:	scoped or more than one screen, describe on next page

Form: OLWR-SWR-1A RECEIVED NOV 2 8 2006 BY: OLWR

N-82


## The sketch below only required for water wells

If well telescopes, show depths on sketch. Ground Level\_

Description of Formations Encountered	From (depth)	To (depth)
cley dirt.	Ground Level	30
red soud	30	40
white clay	40	51
while south	51	155
	1	1
······································		
	-	
······································		
		1
	+	<b> </b>
		1

Description of formations encountered must be provided for all wells and boreholes, unless specifically exempted by regulations

If more than one screen, show location of each on sketch

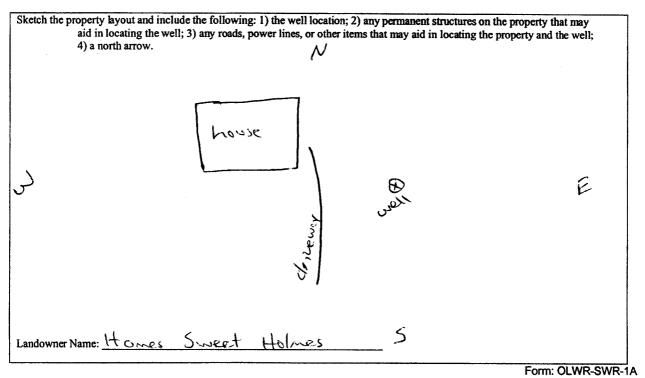

I certify that the well/borehole was drilled, constructed, and completed in accordance with all applicable requirements of the Mississippi Department of Environmental Quality and the Mississippi Department of Health regulations, if applicable, and state laws.

Janes as Mosa 0-670 11-23-06 Date

Print Name of Responsible Licensee and License No.

Signature of Licensee

RECEIVED NOV 28 2006 BY: OLWF

	STATE WELL REPORT	
County: <u>Marshall</u> Permit #: Driller: <u>Janes</u> <u>W. Masand</u> Date completed: <u>11-15-06</u> <u>Copy information from block on Part 1</u>	Part 2 Pump Installer's Completion Report Mississippi Department of Environmental Quality Office of Land and Water Resources P.O. Box 10631 Jackson, MS 39289-0631 (601)961-5210 (601)354-6938 (fax)	For Office Use Only: Aquifer: Well #: M- 82 Elevation:
	a licensed water well contractor or a licensed pum	
report must be attached and both parts filed Well Owner Information	with the Department at the above address within 3	0 days of well completion. Well Location
Owner Name: <u>Homes Sweet</u> Mailing Address: LOT SO Macia	Holmes Latitude: <u>34.43.85</u> <u>51</u> Method of Lat/Long (check	4_Longitude: <u>87,38,501</u> <b>30</b> k one): Conventional Survey,
B <u>thalia Mr</u> City State	3 8611 Zip Code Distance Direction	eld GPS <u>,</u> Survey-grade GPS <u>29 T 4s R 4w</u> n Nearest Town of <u>Orien</u>
<b>Pump Type</b> Circle one		Power Type Circle one
		oline Engine Natural Gas
	Turbine Electric Motor Har	
Centrifugal Rotary F		er (specify):
Other (specify):	Horse Power Rating of Mo	tor: <u>314</u>
Date Pump Installed: 11-15-06	Setting Depth:	<u>25</u> feet
Rated Pump Capacity: Ga	allons Per Minute Number of Stages:	[[
Pump Test Data	Method of	Measuring Water Level
Date Well Tested: 11-15-06		Circle one
r* 1	low Land Surface	Aeasuring Line Steel Tape
Pumping Water Level (B): <u>NA</u> Feet Bel	Other (specify): <u>Stri</u>	ng/weight
• •	clow Land Surface For flowing well, measured	d shut in head: NA feet
		GPM with a drawdown of
Duration of Pump Test (minimum 4 hours):		$\frac{24}{1000}$ Hours of pumping
	ts are true to the best of my knowledge.	

¥ 1 •

NOV 2 8 2005 BY: OLWP