State V	Vell Report		
	Driller's Log	For Office Use Only:	
Mississippi Departmen	nt of Environmental Quality	Aquifer:	
Child of Edite	and Water Resources Box 10631	Well #: <u>N-91</u>	
Jackson, M	MS 39289-0631	L. S. Elevation:	
	)961-5210 54-6938 (fax)	E-log #:	
(001)55	14-0938 (lax)	E-log #:	
State Law requires that this report be prepared by the lic <u>Department</u> at the above address within 30 days of com	cense holder responsible for t nletion of drilling of the well	he work and filed with the or borehole	
Information on Well Owner		rehole Location	
(Landowner if borehole is not for a water well)	Latitude: 34 . 42 . 908	" Longitude: <u>89 • 36 , 257</u> "	
Owner Name Southern Housing	Method of Lat/Long (circle on	15	
Owner Name Southern Housing Mailing Address: 4865 morrigenero cd.			
		GPS, Survey-grade GPS	
	NIKS 1/ NE 1/4 Sec J'	Twn 4s Rng 4w	
Holly Springs MS 38635 City State Zip Code	Distance Direction	Nearest Town	
Telephone No. (662) 838-3773		home form	
Telephone No. (((((((((((((((((((((((((((((((((((			
Well / Bore			
Date drilling started: $\frac{9-15-09}{1000}$ Date drilling completed: $\frac{9-15-09}{100000000000000000000000000000000000$	media Hole depth: 185	Hole diameter: 63/4	
Location of the source of any surface water used for drilling:	Α.		
Method of dosing and volume of Chlorine used in drilling and deve	lopment:		
Logs run (circle all applicable) No log run Electric Gamma Ray Density Sonic Neutron Other:			
Purpose of borehole (check one): Water Well <u>C</u> Geotechnical/Geol	logical Investigation Ground	Source Heat Pump	
Seismic Survey Other (describe If drilling is not related to water well construction		Dek Rie 22007	
Name of organization running log(s):			
If a flowing well, method of flow regulation: Valve C	Other (describe)		
Static Water Level: 140 feet above on below (circle one) land surface Date measured:			
Method of Measurement (circle one) steel tape electric tape air line other: Story (weight			
Well depth: 185 Well grouted to a depth of 10 feet Type of grout (circle one): Neat Cement Bentonite Mix			
Casing length: 165 feet Casing diameter: inches Type of casing:			
Screen length: <u>20</u> feet Screen diameter: <u>4</u> inches Type of screen: <u>puc</u>			
Screen slot size: <u>. 010</u> inches Setting depth: From <u>165</u> feet to <u>185</u> feet			
Type of completion (circle all applicable): Gravel packed Underreamed Telescoped Open hole Natural Development			
Other (describe):			
	lescoped or more than one scree		
		Form: OLWR-SWR-1A	

• •


## The sketch below only required for water wells

If well telescopes, sh	ow depths on sketch.
Ground Level	

wells and boreholes, unless specifically	v exempted by reg	<u>ulations</u>
Description of Formations Encountered	From (depth)	To (depth)
 clay dift.	Ground Level	12
red sound	12	35
while soud	35	100
white clay	100	140
white soud	140	155
while day	155	105
white soud.	165	185
		1
		1
	+	+
		<u> </u>
	·	<u> </u>

Description of formations encountered must be provided for all

If more than one screen, show location of each on sketch

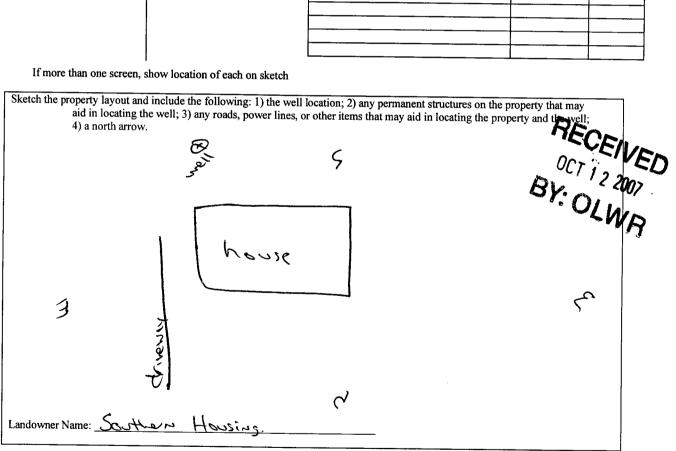

Form: OLWR-SWR-1A

I certify that the well/borehole was drilled, constructed, and completed in accordance with all applicable requirements of the Mississippi Department of Environmental Quality and the Mississippi Department of Health regulations, if applicable, and state laws.

Date

Jones w. Majour 0-620 10-9-07.

Print Name of Responsible Licensee and License No.

fers w. Signature of Licensee

	STATE WELL REPORT	
County: Marshall	Part 2 Pump Installer's Completion Report	For Office Use Only:
Permit #:	Mississippi Department of Environmental Quality Office of Land and Water Resources	Aquifer:
Driller: Jones w. Moson	P.O. Box 10631	Well #: 1/-91
Date completed: $9 - 24 - 07$	Jackson, MS 39289-0631 (601)961-5210	Elevation:
Copy information from block on Part 1	(601)354-6938 (fax)	

.

This part of the report must be completed by a licensed water well contractor or a licensed pump installer. A copy of Part 1 of the report must be attached and both parts filed with the Department at the above address within 30 days of well completion.
Well Owner Information
Well Location

Well Owner Information	well Location	
Owner Name: Southern Housing	Latitude: 34.42,908 Longitude: 89,36,257	
Mailing Address: 4865 Marcianna rd	Method of Lat/Long (check one): Conventional Survey,	
Holly Springs no 38635 City State Zip Code	USGS quad, Hand-held GPS Survey-grade GPS <u>NいパルE % Sec ラフ T 45 R 4い</u> Distance Direction Nearest Town	
Telephone No. (662) 838-3773	1/2 Miles SW of Morionna	

٦

	Pump Type Circle one			Power Type Circle one	
Air Lift	Jet	Submersible	Diesel Engine	Gasoline Engine	Natural Gas
Bucket	Piston	Turbine	Electric Motor	Hand	Tractor PTO
Centrifugal	Rotary	Flowing Well	Windmill	Other (specify):	- An
Other (specify):			Horse Power Rating	g of Motor: 3/4	- 'ECEN
Date Pump Installed:	9-24-01	<u> </u>	Setting Depth:	170	feet OCT
Rated Pump Capacity:	(2	Gallons Per Minute	Number of Stages:		al con
Pump Test Data		Met	hod of Measuring Wat Circle one	er Level	
Date Well Tested:	- 24-07			chele one	
		et Below Land Surface	Air Line El	ectric Measuring Line	Steel Tape
Pumping Water Level (A).			Other (specify):	tring ( weight	·
Drawdown [(B) – (A)]:	<u>۲۰۰۸</u> Fe	et Below Land Surface	For flowing well, n	neasured shut in head: _	feet
Test Pumping Rate:	15	Gallons Per Minute	Well yielded	GPM with	a drawdown of
Duration of Pump Test	(minimum 4 hour	s): <u> </u>		$\hat{e}et after \underline{\partial 4}$	_hours of pumping

I HEREBY CERTIFY that the above statements are true to the best of my knowledge.			
Joner w. Mason 0-620,	Jans w. Man		
Print Name of Pump Installer and License No. (if applicable)	Signature of Pump Installer		
	Form: OLWR-SWR-1B		