	State Well Report	TA OFFICIAL
County: Morshell	Part 1 – Driller's Log	For Office Use Only:
-	Mississippi Department of Environmental Quality	Aquifer:
Permit #:	Office of Land and Water Resources	Well #: <u>N - 9</u> 5
Driller: Janes w. Mason.	P.O. Box 10631	
Date drilling completed: 1 - 20-08	Jackson, MS 39289-0631 (601)961-5210	L. S. Elevation:
Date drilling completed.	(601)354-6938 (fax)	E-log #:
State Law requires that this repo	ort be prepared by the license holder responsible for a	the work and filed with th
	ss within 30 days of completion of drilling of the well	
Information on Well		rehole Location
(Landowner if borehole is not	I atitude. Ju o TJ , O Ho	" Longitude: 89 . 39 . 2
Owner Name Kenny Dun	for a water well) Latitude: $34 \cdot 43 \cdot 346$ Method of Lat/Long (circle or	
Owner Name Kenny Duny Mailing Address: 6496 Ho	Method of Lat/Long (circle or	ne): Conventional Survey,
Mailing Address: 6796 H	4 504).	GPS Survey grade GPS
	$\frac{\text{USGS quad Hand-held}}{\text{NE} \frac{19}{45E} \frac{19}{45E}$	Gro, burvey-grade Ors
	<u>NE45E4 Sec 19</u>	<u>^YTwn YS Rng 40</u>
Byholia A City St	<u>~ 3 32'611</u>	
City St	ate Zip Code Distance Direction	
Telephone No. (901) 490- 306	6 <u> </u>	
		····
	Well / Borehole Data	
Date drilling started: 1-20-08 Date d	Irilling completed: $\frac{1-30\cdot66}{1-30\cdot66}$ Hole depth: $\frac{185'}{1}$	Hole diameter: $63/4$
		·····
Location of the source of any surface wa	ter used for drilling: <u>NA</u>	
Location of the source of any surface wa Method of dosing and volume of Chlorin	ter used for drilling: <u>مىم</u> ne used in drilling and development: مىم	
Method of dosing and volume of Chlorin	ne used in drilling and development:	Other:
Method of dosing and volume of Chlorin Logs run (circle all applicable): No log ru	ne used in drilling and development: <u>محمد</u> up> Electric Gamma Ray Density Sonic Neutron	
Method of dosing and volume of Chlorin Logs run (circle all applicable): No log run Name of organization running log(s):	ne used in drilling and development:	
Method of dosing and volume of Chlorin Logs run (circle all applicable): No log run Name of organization running log(s):	ne used in drilling and development: <u>A</u>	
Method of dosing and volume of Chlorin Logs run (circle all applicable): No log ru Name of organization running log(s): Purpose of borehole (check one): Water V Seismic	ne used in drilling and development: <u>A</u> up) Electric Gamma Ray Density Sonic Neutron A Well <u>Geotechnical/Geological Investigation</u> Ground Survey Other (<i>describe</i>)	Source Heat Pump
Method of dosing and volume of Chlorin Logs run (circle all applicable): No log ru Name of organization running log(s): Purpose of borehole (check one): Water V Seismic	ne used in drilling and development:	Source Heat Pump
Method of dosing and volume of Chlorin Logs run (circle all applicable): <u>Volog ru</u> Name of organization running log(s): Purpose of borehole (check one): Water V Seismic <u>If drilling is not relate</u>	ne used in drilling and development:	Source Heat Pump
Method of dosing and volume of Chlorin Logs run (circle all applicable): <u>Volog ru</u> Name of organization running log(s): Purpose of borehole (check one): Water V Seismic <u>If drilling is not relate</u>	ne used in drilling and development: <u>A</u> up) Electric Gamma Ray Density Sonic Neutron A Well <u>Geotechnical/Geological Investigation</u> Ground Survey Other (<i>describe</i>)	Source Heat Pump
Method of dosing and volume of Chlorin Logs run (circle all applicable): No log ru Name of organization running log(s): Purpose of borehole (check one): Water V Seismic If drilling is not relate Purpose of Well (check one): Home	ne used in drilling and development:	Source Heat Pump
Method of dosing and volume of Chlorin Logs run (circle all applicable): No log ru Name of organization running log(s): Purpose of borehole (check one): Water V Seismic If drilling is not relate Purpose of Well (check one): Home If a flowing well, method of flow regulation	ne used in drilling and development:	Source Heat Pump
Method of dosing and volume of Chlorin Logs run (circle all applicable): <u>Volog ru</u> Name of organization running log(s): Purpose of borehole (check one): Water V Seismic <u>If drilling is not relate</u> Purpose of Well (check one): Home <u><</u> If a flowing well, method of flow regulati Static Water Level: <u>(20</u> feet a	ne used in drilling and development:	Source Heat Pump ock Other: 1- 2 4- 08
Method of dosing and volume of Chlorin Logs run (circle all applicable): <u>Volog ru</u> Name of organization running log(s): Purpose of borehole (check one): Water V Seismic <u>If drilling is not relate</u> Purpose of Well (check one): Home <u><</u> If a flowing well, method of flow regulati Static Water Level: <u>\\$C</u> feet a	ne used in drilling and development:	Source Heat Pump ock Other: 1- 2 4- 08
Method of dosing and volume of Chlorin Logs run (circle all applicable): <u>Volog ru</u> Name of organization running log(s): Purpose of borehole (check one): Water V Seismic If drilling is not relate Purpose of Well (check one): Home <u>/</u> If a flowing well, method of flow regulati Static Water Level: <u>() C</u> feet a Method of Measurement (circle one) set	ne used in drilling and development:	Source Heat Pump Other: 1- 24-08
Method of dosing and volume of Chlorin Logs run (circle all applicable): <u>Volog run</u> Name of organization running log(s): Purpose of borehole (check one): Water V Seismic If drilling is not relate Purpose of Well (check one): Home <u>V</u> If a flowing well, method of flow regulati Static Water Level: <u>Voc</u> feet a Method of Measurement (circle one)	ne used in drilling and development:	Source Heat Pump Other: 1- 24-08
Method of dosing and volume of Chlorin Logs run (circle all applicable): No log run Name of organization running log(s): Purpose of borehole (check one): Water V Seismic If drilling is not relate Purpose of Well (check one): Home \checkmark If a flowing well, method of flow regulati Static Water Level:feet a Method of Measurement (circle one) = s Well depth: $\frac{185}{25}$ Well grouted to a d	ne used in drilling and development:	Source Heat Pump
Method of dosing and volume of Chlorin Logs run (circle all applicable): No log run Name of organization running log(s): Purpose of borehole (check one): Water V Seismic If drilling is not relate Purpose of Well (check one): Home \checkmark If a flowing well, method of flow regulation Static Water Level:feet a Method of Measurement (circle one) as Well depth: $\frac{165}{2}$ Well grouted to a d Casing length:feet Cas	ne used in drilling and development: up Electric Gamma Ray Density Sonic Neutron WellGeotechnical/Geological Investigation Ground SurveyOther (<i>describe</i>) <i>d to water well construction, skip the remainder of this bla</i> IndustrialPublic SupplyIrrigation Fish Culture ion: Valve Other (describe) store tape Other (describe) elepth of <u>{0</u> feet feet type of grout (circle one): Neat Cem- ing diameter: inches Type of casing:	Source Heat Pump pck Other: 1- 2 V- 0.8 (weight ent Bentonite) Mix OU
Method of dosing and volume of Chlorin Logs run (circle all applicable): No log run Name of organization running log(s): Purpose of borehole (check one): Water V Seismic If drilling is not relate Purpose of Well (check one): Home \checkmark If a flowing well, method of flow regulating Static Water Level:feet a Method of Measurement (circle one) as Well depth: $\frac{165}{2}$ Well grouted to a d Casing length:feet Cas	ne used in drilling and development: up Electric Gamma Ray Density Sonic Neutron WellGeotechnical/Geological Investigation Ground SurveyOther (<i>describe</i>) <i>d to water well construction, skip the remainder of this bla</i> IndustrialPublic SupplyIrrigation Fish Culture ion: Valve Other (describe) store tape Other (describe) elepth of <u>{0</u> feet feet type of grout (circle one): Neat Cem- ing diameter: inches Type of casing:	Source Heat Pump pck Other: 1- 2 V- 0.8 (weight ent Bentonite) Mix OU
Method of dosing and volume of Chlorin Logs run (circle all applicable): No log run Name of organization running log(s): Purpose of borehole (check one): Water V Seismic If drilling is not relate Purpose of Well (check one): Home \checkmark If a flowing well, method of flow regulati Static Water Level: feet a Method of Measurement (circle one) = s Well depth: $\frac{165}{2}$ Well grouted to a d Casing length: feet Cas Screen length: feet Scr	ne used in drilling and development: he used in drillin	Source Heat Pump
Method of dosing and volume of Chlorin Logs run (circle all applicable): No log run Name of organization running log(s): Purpose of borehole (check one): Water V Seismic If drilling is not relate Purpose of Well (check one): Home \checkmark If a flowing well, method of flow regulati Static Water Level: feet a Method of Measurement (circle one) = s Well depth: $\frac{165}{2}$ Well grouted to a d Casing length: feet Cas Screen length: feet Scr Screen slot size: () ()	ne used in drilling and development: <u>A</u> un) Electric Gamma Ray Density Sonic Neutron WellGeotechnical/Geological InvestigationGround SurveyOther (<i>describe</i>) <i>d to water well construction, skip the remainder of this bla</i> IndustrialPublic SupplyIrrigationFish Culture ion: ValveAOther (describe) toon: ValveAOther (describe) steel tape electric tape air line other: <u>Str.</u> lepth of <u>{}</u> feet Type of grout (circle one): Neat Cem ing diameter: inches Type of casing: een diameter: inches Type of screen: Setting depth: From feet to(Source Heat Pump pck Other: $1 - \partial V - O \partial$ $1 - \partial V - O \partial$ 1 - O O - O - O 1 - O - O - O - O 1 - O - O - O - O - O - O - O - O - O -
Method of dosing and volume of Chlorin Logs run (circle all applicable): No log run Name of organization running log(s): Purpose of borehole (check one): Water V Seismic If drilling is not relate Purpose of Well (check one): Home \checkmark If a flowing well, method of flow regulati Static Water Level: feet a Method of Measurement (circle one) = s Well depth: $\frac{165}{2}$ Well grouted to a d Casing length: feet Cas Screen length: feet Scr Screen slot size: (10) inches	ne used in drilling and development: he used in drillin	Source Heat Pump pck Other: $1 - \partial V - O \partial$ $1 - \partial V - O \partial$ 1 - O O - O - O 1 - O - O - O - O 1 - O - O - O - O - O - O - O - O - O -
Method of dosing and volume of Chlorin Logs run (circle all applicable): No log run Name of organization running log(s): Purpose of borehole (check one): Water V Seismic If drilling is not relate Purpose of Well (check one): Home \checkmark If a flowing well, method of flow regulati Static Water Level: feet a Method of Measurement (circle one) = s Well depth: $\frac{165}{2}$ Well grouted to a d Casing length: feet Cas Screen length: feet Scr Screen slot size: () ()	ne used in drilling and development: <u>A</u> un) Electric Gamma Ray Density Sonic Neutron WellGeotechnical/Geological InvestigationGround SurveyOther (<i>describe</i>)	Source Heat Pump pck Other: $1 - \partial V - O \partial$ $1 - \partial V - O \partial$ 1 - O O - O - O - O - O 1 - O - O - O - O - O - O - O - O - O -
Method of dosing and volume of Chlorin Logs run (circle all applicable): <u>Volog run</u> Name of organization running log(s): Purpose of borehole (check one): Water V Seismic If drilling is not relate Purpose of Well (check one): Home \checkmark If a flowing well, method of flow regulati Static Water Level: <u>(20)</u> feet a Method of Measurement (circle one) Well depth: <u>165</u> feet Cas Screen length: <u>200</u> feet Scr Screen slot size: <u>010</u> inches Type of completion (circle all applicable)	ne used in drilling and development: <u>A</u> up Electric Gamma Ray Density Sonic Neutron WellGeotechnical/Geological InvestigationGround SurveyOther (<i>describe</i>) <i>d to water well construction, skip the remainder of this bla</i> IndustrialPublic SupplyIrrigationFish Culture ion: ValveAOther (describe) above or below (circle one) land surfaceDate measured: steel tape electric tape air line other: <u>Strict</u> lepth of <u>10</u> feetType of grout (circle one): Neat Cemming diameter:inchesType of casing: een diameter:inchesfeet to Setting depth: From feet to Other (describe):	Source Heat Pump pckOther: $1 - \partial V - O \partial$ $2 - \partial V - O \partial$ ent Bentonite Mix $p - U$ $p - U$ $\partial Sfeet$ hole Natural Development
Method of dosing and volume of Chlorin Logs run (circle all applicable): <u>Volog run</u> Name of organization running log(s): Purpose of borehole (check one): Water V Seismic If drilling is not relate Purpose of Well (check one): Home \checkmark If a flowing well, method of flow regulati Static Water Level: <u>(20)</u> feet a Method of Measurement (circle one) Well depth: <u>165</u> feet Cas Screen length: <u>200</u> feet Scr Screen slot size: <u>010</u> inches Type of completion (circle all applicable)	ne used in drilling and development: <u>A</u> un) Electric Gamma Ray Density Sonic Neutron WellGeotechnical/Geological InvestigationGround SurveyOther (<i>describe</i>)	Source Heat Pump pckOther: $1 - \partial V - O \partial$ $2 - \partial V - O \partial$ ent Bentonite Mix $p - U$ $p - U$ $\partial Sfeet$ hole Natural Development

APR 71 MAR BY OLVAR

N-95

The sketch below only required for water wells


If well telescopes, show depths on sketch.

Ground Level_

Description of formations encountered must be provided for all wells and boreholes, unless specifically exempted by regulations

Description of Formations Encountered	From (depth)	To (depth)
Clay dirt.	Ground Level	15
Fed soud	15	40
white souch	40	185
		1
· · · · · · · · · · · · · · · · · · ·		
······		
· · · · · · · · · · · · · · · · · · ·	1 .	
	-	
·····		
· · · · · · · · · · · · · · · · · · ·		
		1

If more than one screen, show location of each on sketch

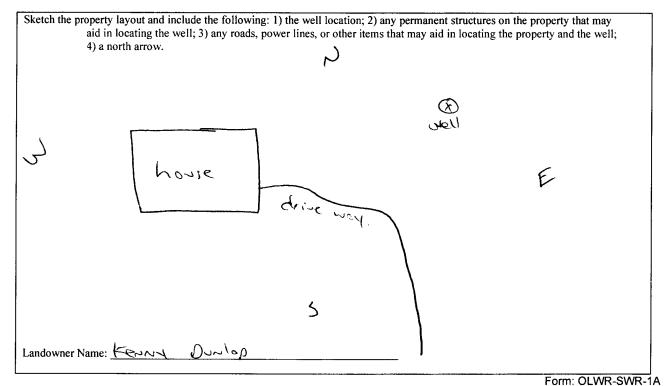

I certify that the well/borehole was drilled, constructed, and completed in accordance with all applicable requirements of the Mississippi Department of Environmental Quality and the Mississippi Department of Health regulations, if applicable, and state laws.

Date

2-16-08. w. Mason 0-670 Jones

ong w.N

Print Name of Responsible Licensee and License No.

Signature of Licensee

行民族 建成合物 BY OLAR

County: Marshall	Part 2	For Office Use Only:
Permit #:	Pump Installer's Completion Report Mississippi Department of Environmental Quality	Aquifer:
Driller: Jones W. Mosch	Office of Land and Water Resources P.O. Box 10631	
Date completed: 1-24-08	Jackson, MS 39289-0631	Well #: <u>N-95</u>
Copy information from block on Part 1	(601)961-5210 (601)354-6938 (fax)	Elevation:

OTATE WELL DEDODT

	This part of the report must be completed by a licensed water well c report must be attached and both parts filed with the Department as	t the above address within 30 days of well completion.
1	Well Owner Information	Well Location

Wen Owner Information			
Owner Name: Kenny	Dunlop		Latitude: 34.4
Mailing Address: 6496	Hun 30	195	Method of Lat/Lo
			USGS quad
Byhalic	MS	38611	NE 4SE
City	State	Zip Code	

Telephone No. (101) 490-3066

i ine uo	ove address within 30 days of well completion. Well Location
Latit	ude: 34.43.296 Longitude: 89.39.272.
Metho	od of Lat/Long (check one): Conventional Survey,
USG	S quad, Hand-held GPS, Survey-grade GPS
NE	4 SE 4 Sec 19 T 45 R 4w
Dista	nce Direction Nearest Town
<u> (18</u>	Miles No of Orion

	Pump Type Circle one			Power Type Circle one	
Air Lift	Jet	Submersible	Diesel Engine	Gasoline Engine	Natural Gas
Bucket	Piston	Turbine	Electric Motor	Hand	Tractor PTO
Centrifugal	Rotary	Flowing Well	Windmill	Other (specify):	
Other (specify):			Horse Power Rating	g of Motor: <u>3/4</u>	
Date Pump Installe	d: 1-34-08	·	Setting Depth:	140	feet
Rated Pump Capac	ity: (0	Gallons Per Minute	Number of Stages:	8	

Pump Test Data	Method of Measuring Water Level		
Date Well Tested: 1- 24-08	Circle one		
	Air Line Electric Measuring Line Steel Tape		
Static Water Level (A):Feet Below Land Surface	Other (specify): String (weight		
Pumping Water Level (B):Feet Below Land Surface			
Drawdown [(B) – (A)]:Feet Below Land Surface	For flowing well, measured shut in head:feet		
Test Pumping Rate: (V Gallons Per Minute	Well yielded GPM with a drawdown of		
Duration of Pump Test (minimum 4 hours): <u>34</u> hours	feet after hours of pumping		

I HEREBY CERTIFY that the above statements are true to the best of	my knowledge.
Jores W. Mosen 0.620	Jow Man
Print Name of Pump Installer and License No. (if applicable)	Signature of Pump Installer
	Form: OtWR-SWR-1B

FER 25 2008 BY OLVER