	State Well Report	
County: Morsholl	Part 1 – Driller's Log	For Office Use Only:
	Mississippi Department of Environmental Quality	Aquifer:
Permit #:	Office of Land and Water Resources	Well #: N-96
Driller: Jones W. Majon	P.O. Box 10631 Jackson, MS 39289-0631	L. S. Elevation:
Date drilling completed: 4-25-08	(601)961-5210	L. S. Elevation:
	(601)354-6938 (fax)	E-log #:
	ort be prepared by the license holder responsible for	
Information on Well	ss within 30 days of completion of drilling of the we	<i>li or dorenole.</i> Borehole Location
(Landowner if borehole is not j	for a mater well	
Owner Name	Latitude: $34 \circ 43$, 03	6, Longitude: <u>89°35, 438</u> 2 Done): Conventional Survey,
•	Method of Lat/Long (circle)	A Conventional Survey.
Mailing Address: 4428 5mi	the gradule rd.	
	USGS quad, Hand-hel	d GPS, Survey-grade GPS
	DE 1/2 500 1/2 Sec 23	3 Twn 45 Rng 4w
Holly Springs City Sta	Mr 30055 5E	
City Sta	ate Zip Code Distance Direction	Nearest Town of <u>Marianno 0</u>
Telephone No. (60) 564-350	<u>)</u>	
	Well / Borehole Data	
DU THE CONTRACTOR	rilling completed: 4-25-08 Hole depth: 185	C31
Date drifting started: <u>COS-OU</u> Date di	rilling completed: <u>4 3 500</u> Hole depth: <u>103</u>	Hole diameter: 6-14
Location of the source of any surface wat		
Method of dosing and volume of Chlorin	ne used in drilling and development:	
Logs run (circle all applicable): <u>No log ru</u> Name of organization running log(s):	Electric Gamma Ray Density Sonic Neutron	Other:
Purpose of borehole (check one): Water W	Vell $\underline{\checkmark}$ Geotechnical/Geological Investigation Groun	d Source Heat Pump
Seismic	SurveyOther (<i>describe</i>)	
	d to water well construction, skip the remainder of this b	lock
If drilling is not related		
If drilling is not related Purpose of Well (check one): Home	d to water well construction, skip the remainder of this b	Other:
If drilling is not related Purpose of Well (check one): Home If a flowing well, method of flow regulation	<u>d to water well construction, skip the remainder of this b</u> Industrial Public Supply Irrigation Fish Culture	Other:
If drilling is not related Purpose of Well (check one): Home I If a flowing well, method of flow regulation Static Water Level: 134 feet al	<i>d to water well construction, skip the remainder of this b</i> Industrial Public Supply Irrigation Fish Culture on: Valve Other (describe)	Other: 5-5-08
If drilling is not related Purpose of Well (check one): Home I If a flowing well, method of flow regulation I Static Water Level: 134 feet all Method of Measurement (circle one) state	d to water well construction, skip the remainder of this b Industrial Public Supply Irrigation Fish Culture on: Valve Other (describe) Other (describe) bove or below (circle one) land surface	
If drilling is not related Purpose of Well (check one): Home \checkmark If a flowing well, method of flow regulation Static Water Level: 134 feet all Method of Measurement (circle one) Static Well depth: 135 Well grouted to a definition	d to water well construction, skip the remainder of this b Industrial Public Supply Irrigation Fish Culture on: Valve Other (describe) bove of below (circle one) land surface bate measured: teel tape electric tape air line other: Structure bove of below (circle one) bove of below (circle one) teel tape electric tape air line other: Structure teel tape electric tape air line other: Structure teel tape teel tape	Other: 5-5-08
If drilling is not related Purpose of Well (check one): Home I If a flowing well, method of flow regulation Static Water Level: 134 feet all Method of Measurement (circle one) state state Well depth: 135 Well grouted to a de Casing length: 155 feet	d to water well construction, skip the remainder of this b Industrial Public Supply Irrigation Fish Culture on: Valve Other (describe) bove of below (circle one) land surface Date measured: teel tape electric tape air line other: <u>Str</u> epth of <u>10</u> feet Type of grout (circle one): Neat Cer ng diameter:	Other: 5-5-08 Ting (reight. nent Bentonite) Mix Auc
If drilling is not related Purpose of Well (check one): Home I If a flowing well, method of flow regulation Static Water Level: 134 feet at Method of Measurement (circle one) state Well depth: 195 Well grouted to a de Casing length: 125 feet Casing Screen length: 106 feet Screen	d to water well construction, skip the remainder of this b Industrial Public Supply Irrigation Fish Culture on: Valve Other (describe) bove of below (circle one) land surface bate measured: teel tape electric tape air line other: Structure bove of below (circle one) bove of below (circle one) teel tape electric tape air line other: Structure teel tape electric tape air line other: Structure teel tape teel tape	Other: 5-5-08 inent Bentonite Mix puc puc
If drilling is not related Purpose of Well (check one): Home I If a flowing well, method of flow regulation Static Water Level: 134 feet all feet all feet all Method of Measurement (circle one) si Well depth: 195 Well grouted to a de Casing length: 105 feet Casin Screen length: 10 feet Scree Screen slot size: 010 inches	d to water well construction, skip the remainder of this b Industrial Public Supply Irrigation Fish Culture on: Valve Other (describe) bove or below (circle one) land surface Date measured: teel tape electric tape epth of 10 feet Type of grout (circle one): Neat Cer ng diameter: inches teen diameter: inches	Deter: 5-5-08 Dive (veight. nent Bentonite) Mix puc puc feet
If drilling is not related Purpose of Well (check one): Home I If a flowing well, method of flow regulation Static Water Level: 134 feet all Method of Measurement (circle one) static Well depth: 195 Well grouted to a de Casing length: 105 feet Casing Screen length: 10 feet Screen Screen slot size: 010 inches	d to water well construction, skip the remainder of this b Industrial Public Supply Irrigation Fish Culture on: Valve Other (describe) bove of below (circle one) land surface Date measured: teel tape electric tape epth of 10 feet Type of grout (circle one): Neat Cer ng diameter: inches Type of casing: setting depth: From 175 feet to Gravel packed Underreamed Telescoped Oper	$\frac{5-5-08}{5-5-08}$ $5-$
If drilling is not related Purpose of Well (check one): Home I If a flowing well, method of flow regulation Static Water Level: 134 feet all Method of Measurement (circle one) static Well depth: 195 Well grouted to a dee Casing length: 195 feet Casing Screen length: 10 feet Scree Screen slot size: 010 inches Type of completion (circle all applicable). Static Scree Scree	d to water well construction, skip the remainder of this b Industrial Public Supply Irrigation Fish Culture on: Valve Other (describe) bove or below (circle one) land surface Date measured: teel tape electric tape epth of 10 feet Type of grout (circle one): Neat Cer ng diameter: inches Type of screen: Setting depth: From 175 feet to	


· ·

MAY 27 2008 BY: OLW R

N- 96

The sketch below only required for water wells




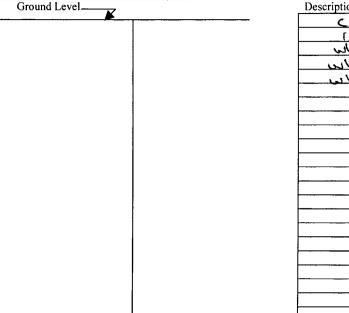

<u>Description of formations encountered must be provided for all</u> wells and boreholes, unless specifically exempted by regulations

Description of Formations Encountered	From (depth)	To (depth)
cley diff.	Ground Level	10
red Soud	10	45
white soud	45	100
white cley	100	135
white soud.	135	185
	1	
		1
1		
· · · · · · · · · · · · · · · · · · ·		
· · · · · · · · · · · · · · · · · · ·		1
	1	
		+
	<u> </u>	

If more than one screen, show location of each on sketch

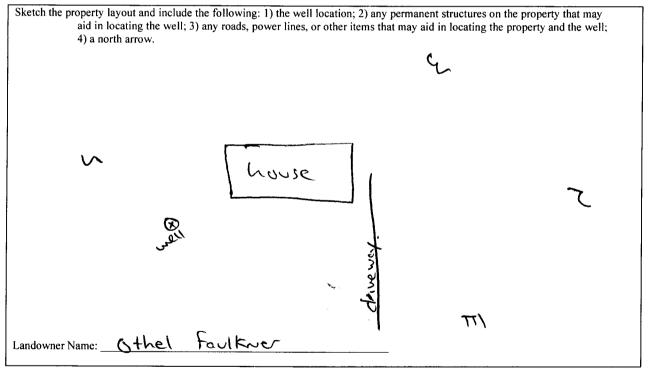

Form: OLWR-SWR-1A

I certify that the well/borehole was drilled, constructed, and completed in accordance with all applicable requirements of the Mississippi Department of Environmental Quality and the Mississippi Department of Health regulations, if applicable, and state laws.

Date

0-620 5-21-08 ones w. Mason

Print Name of Responsible Licensee and License No.

en v v Signature of Licensee

RECEIVED MAY 27 2008 BY: OLWR

County: Marshall	Part 2 Pump Installer's Completion Report	For Office Use Only:
ermit #:	Mississippi Department of Environmental Quality	Aquifer:
Driller: Jones w. Moson	Office of Land and Water Resources P.O. Box 10631	
ate completed: 5-5-08	Jackson, MS 39289-0631	Well #: <u>N-76</u>
opy information from block on Part 1	(601)961-5210 (601)354-6938 (fax)	Elevation:

DD

OTE A TELE XX/ENT T

This part of the report must be completed by a licensed water well report must be attached and both parts filed with the Department a			
Well Owner Information	Well Location		
Owner Name: Other Fourther	Latitude: 34.43.036 Longitude: 89.35.434		
Mailing Address: 4428 Smith groune rd	Method of Lat/Long (check one): Conventional Survey,		
	USGS quad, Hand-held GPS, Survey-grade GPS		
Holly Springs MS 38635 City State Zip Code	NE 1/ SW 1/ Sec 23 T 45 R 4W		
	Distance Direction Nearest Town		
Telephone No. (62)	12 Miles E of Marianna		

Pump Type Circle one		Power Type Circle one			
Air Lift	Jet	Submersible	Diesel Engine	Gasoline Engine	Natural Gas
Bucket	Piston	Turbine (Electric Motor	Hand	Tractor PTO
Centrifugal	Rotary	Flowing Well	Windmill	Other (specify):	·······
Other (specify):			Horse Power Rating of Motor: 3/4		
Date Pump Installed:	5-5-08		Setting Depth:	(60	_feet
Rated Pump Capacity: _	(0)	_Gallons Per Minute	Number of Stages:	8	_

Pump Test Data	Method of Measuring Water Level		
Date Well Tested: 5-5-08	Circle one		
Static Water Level (A): <u>(34</u> Feet Below Land Surface	Air Line Electric Measuring Line Steel Tape Other (specify): String (meight		
Pumping Water Level (B): <u>M</u> Feet Below Land Surface	5		
Drawdown [(B) – (A)]: Feet Below Land Surface Test Pumping Rate: Gallons Per Minute	For flowing well, measured shut in head:		
Duration of Pump Test (minimum 4 hours): 24 hours	Well yielded GPM with a drawdown of feet after 24 hours of pumping		

	I HEREBY CERTIFY that the above statements are true to the best o	of my knowledge.		
	Jones w Moson 0-620	Jus w. Men		
Ì	Print Name of Pump Installer and License No. (if applicable)	Signature of Pump Installer		
			Form: OLMECEVEI	2

MAY 27 2008 BY: OLW R