|  | 1 STATE V   | VELL REPORT  |                                 |  |
|--|---|--|---------------------------------|--|
| County: Morshall 92  | Part 1  |  | For Office Hee Only:            |  |
| Permit #:  | Driller's Log   |  | Well #: N/15                    |  |
| Driller: Janes w. Mason  |   | nent of Environmental Quality<br>Id and Water Resources  | Aquifer:                        |  |
| Date drilling completed: 8-4-16  | P.  | O. Box 2309  | E-Log #:                        |  |
|  | 4   | n, MS 39225-2309<br>01)961-5210  |                                 |  |
|  | (601  | )360-0535 (fax)  |                                 |  |
| State Law requires that this report<br>Department at the above address   |   |  |                                 |  |
| Department at the above address within 30 days of con<br>Well Owner Information  |   | Well or Borehole Location  |                                 |  |
| (Landowner if borehole is not for a water well)  |   | Latitude: 34 44 40.6 N Longitude: 89 39 31. 43 " W   |                                 |  |
| Owner Name: Johnny Sweet   |   |  | -                               |  |
| Mailing Address: 1736 mt   | Sinai 1d.   | Method of Lat/Long (check one  |                                 |  |
|  |   | USGS quad, Hand-held GPS, Survey-grade GPS   |                                 |  |
| Byhalia MJ<br>City State   | 38611   | <u>560 14 SE 14, Sec</u>   | <u>7 τ 45 R 4ω</u>              |  |
|  | 1   | A Miles NW of  | Ocioni                          |  |
| Telephone No. ( <u>901</u> ) <u>488-36</u>   | <u> </u>  | (Distance) (Direction)   | (Nearest Town)                  |  |
|  | r Well Geotechnic<br>nic Survey Other (a                | describe)  | Ground Source Heat Pump         |  |
| If drilling is not re  | lated to water well co                                  | nstruction, skip the remainder   | of this block                   |  |
| Purpose of Well (circle all applicable)  | Home Industrial   | Public Supply Irrigation   | Fish Culture                    |  |
| Other (describe):  |   |  | -                               |  |
| If a flowing well, method of flow regu   | lation: Valve   | いた Other (describe) い  | ([A                             |  |
| Static Water Level: <u>36</u> fee  | •   |  |                                 |  |
| Method of measurement (circle one):  |   |  |                                 |  |
| Well depth: $125$ Well grouted to  |   |  |                                 |  |
| Casing length:feet C   | asing diameter:   | 4 inches Type of c   | asing: <u><u><u>n</u>vc</u></u> |  |
|  |   |  | - 1                             |  |
| Screen length:feet   | Screen diameter:  |  | •                               |  |
| Screen length: $\frac{l0}{c}$ feet<br>Screen slot size: $\frac{c}{c}$ inches   | Screen diameter:<br>Setting depth:                      |  | •                               |  |
| Screen length: $logithing \frac{logithing logithing length}{logithing logithing lengthing length logithing length logithing logit$ | Screen diameter:<br>Setting depth:<br>Ie: Gravel packed |  | •                               |  |
| Screen length: $logitimes$ feet<br>Screen slot size: $control control co$  | Screen diameter:<br>Setting depth:<br>le: Gravel packed |  | screen:                         |  |
| Screen slot size: $\sqrt{2}(0)$ inches<br>Type of completion ( <i>circle all applicab</i><br>Other ( <i>describe</i> ): $\mathcal{N}(\mathcal{P})$<br>Top of lap pipe or reduction in casing   | Setting depth:  | Inches     Type of the second se | screen:                         |  |

Form: OLWR-SWR-1A (4/13)


·-----

| County:   | ] |
|-----------|---|
| Permit #: |   |

| For Office Use Only: |
|----------------------|
| Well #:              |
|                      |

The sketch below only required for water wells



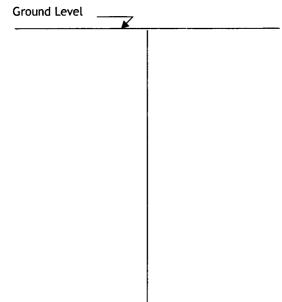

Description of formations encountered must be provided for all wells and boreholes, unless specifically exempted by regulations

| Description of Formations Encountered | From (depth) | To (depth) |
|---------------------------------------|--------------|------------|
| clay dirt                             | Ground level | 25         |
| write soud                            | 25           | 125        |
|                                       |              |            |
|                                       |              |            |
If more than one screen, show location of each on sketch

