


Marshall  
 N 2000  
 10-24-75

MISSISSIPPI  
 BOARD OF WATER COMMISSIONERS  
 416 North State Street  
 Jackson, Mississippi 39201

WATER WELL DRILLERS LOG

Oct 24 1975 date well completed  
 Earl Jones Well Co. firm name  
 Marshall county well located

LANDOWNER:	description of formations encountered:	from	to
C. N. Royer			
Byholia miss RT. 3. (mailing address)	Topsoil + clay	0	19
	sand	19	87
	clay	87	97
	sand + clay mixed	97	150
	sand	150	170
WELL LOCATION: sec 3 T. 4 N. R. 4 E 15E S. W. 6 miles S of Victoria (distance) (direction) (nearest town)			
WELL PURPOSE: Home (home, irrigation, municipal, industrial)			
WELL COMPLETION DATA:			
(1) diameter (inches) 4"			
(2) total depth (feet) 170'			
(3) static water level (feet) 120' below top of ground.			
(4) casing: plastic 160' (material) (depth)			
4" if telescope see back. (size)			
(5) screen: 10' 160' (length) (depth to top)			
4" 013 plastic (size) (material)			
(6) pump: 1/2 12 (HP) (yield gpm)			
Electric (type power)			
(7) electric log: No. (yes or no)			
(organization running log)			
(8) how well bottom plugged: plastic cap.			
DRILLERS REMARKS:			

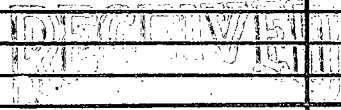

OCT 28 1975

If well telescopes please sketch and show depths.

GROUND LEVEL

X			

SECTION 3

Please indicate well location X.

ADDITIONAL INFORMATION

If more than one screen, show locations of each on sketch.