

MARSHALL
 N 2001
 3-24-76

MISSISSIPPI
 BOARD OF WATER COMMISSIONERS
 416 North State Street
 Jackson, Mississippi 39201

WATER WELL DRILLERS LOG

3-24-1976 ^{15E} *W.C. Mason* *Marshall*
 date well completed firm name county well located

LANDOWNER:
Dennis Fox
 Rt. 3, Holly Springs, Miss.
 (mailing address)

WELL LOCATION:
 sec. 31 T. 4 N. R. 4 E.
1 1/2 miles South of Orion
 (distance) (direction) (nearest town)

WELL PURPOSE: Home
 (home, irrigation, municipal, industrial)

WELL COMPLETION DATA:

(1) diameter (inches) 4"

(2) total depth (feet) 186'

(3) static water level (feet) 127 below
 top of ground. above

(4) casing Pvc Plastic 176'
 (material) (depth)
4"
 (size) if telescope see back.

(5) screen 10' 176'
 (length) (depth to top)
4" Pvc Plastic
 (size) (material)

(6) pump 3/4 10
 (HP) (yield gpm)
Electric
 (type power)

(7) electric log NO
 (yes or no)

(organization running log)

description of formations encountered	from	to
<i>Clay Lert</i>	<i>10</i>	<i>6</i>
<i>Red sand</i>	<i>6</i>	<i>55</i>
<i>white sand</i>	<i>55</i>	<i>186</i>

(8) how well bottom plugged
cap on screen


DRILLERS REMARKS:

RECEIVED
 JUN 28 1976

MISS. Bd. OF WATER COMMISSIONERS

If well telescopes please sketch and show depths.

GROUND LEVEL

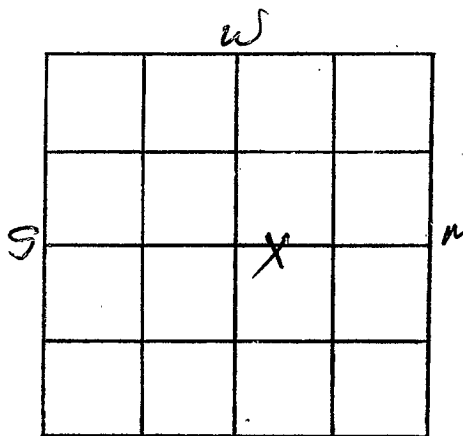

SECTION 31

Please indicate well location X.

ADDITIONAL INFORMATION

If more than one screen, show locations of each on sketch.