

Marshall
 N 2002
 5/8/76

MISSISSIPPI
 BOARD OF WATER COMMISSIONERS
 416 North State Street
 Jackson, Mississippi 39201

WATER WELL DRILLERS LOG

5-8-1976 ^{with margin} Water Well Center Marshall
 date well completed firm name county well located

LANDOWNER:
 James P. Bowman
 RFD - Holly Springs, Miss.
 (mailing address)


description of formations encountered	from	to
clay lent	0	8
Red sand	8	60
concrete sand	60	150

WELL LOCATION:
 sec 29 T 4 N R 4 E
 2 3/4 miles SW of Marianne
 (distance) (direction) (nearest town)

WELL PURPOSE: Home
 (home, irrigation, municipal, industrial)

- WELL COMPLETION DATA:
- (1) diameter (inches) 4 1/2"
 - (2) total depth (feet) 150'
 - (3) static water level (feet) 80' below top of ground
 - (4) casing PVC plastic, 140' (material) (depth)
 4" (size) if telescope see back.
 - (5) screen 10' 140' (length) (depth to top)
 4" PVC plastic (size) (material)
 - (6) pump 3/4 HP 10 (yield gpm)
 electric (type power)
 - (7) electric log NO (yes or no)
- (organization running log)
- (8) how well bottom plugged cap on screen

DRILLERS REMARKS:

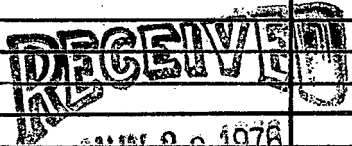


JUN 28 1976

MISS. Bd. OF WATER COMMISSIONERS

If well telescopes please sketch and show depths.

GROUND LEVEL

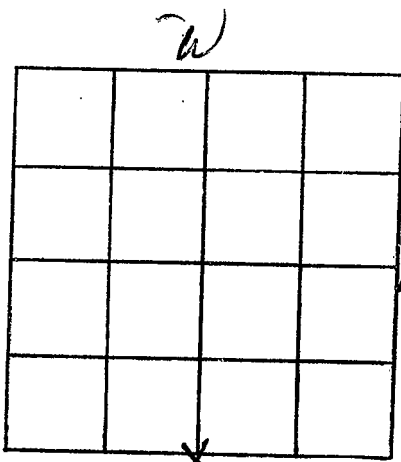

SECTION 29

Please indicate well location X.

ADDITIONAL INFORMATION

If more than one screen,
show locations of each on sketch.