

Marshall
 N 2003
 6-2-76

MISSISSIPPI
 BOARD OF WATER COMMISSIONERS
 416 North State Street
 Jackson, Mississippi 39201

15E

WATER WELL DRILLERS LOG

6-2-76 date well completed
 W & M Mason Water Well Contr. firm name
 Marshall county well located

LANDOWNER:
 Maude Spears
 RFD - Byhalia Miss
 (mailing address)

description of formations encountered	from	to
Clay dirt	70	20
Red sand	20	70
white sand	70	150

WELL LOCATION:
 sec. 18 T. 4 N. R. 15 E.
 4 1/2 miles SE of Watson
 (distance) (direction) (nearest town)

WELL PURPOSE: Home
 (home, irrigation, municipal, industrial)

WELL COMPLETION DATA:

(1) diameter (inches) 4"

(2) total depth (feet) 150'

(3) static water level (feet) 108' below top of ground

(4) casing (material) (depth) PVC Plastic 98'

4" (size) if telescope see back.

(5) screen (length) (depth to top) 10' 98'

4" (size) PVC Plastic (material)

(6) pump (HP) (yield gpm) 3/4 10

electric (type power)

(7) electric log (yes or no) No

(organization running log)


(8) how well bottom plugged
 Cap on Still

DRILLERS REMARKS:

RECEIVED
 JUN 28 1976

If well telescopes please sketch and show depths.

GROUND LEVEL

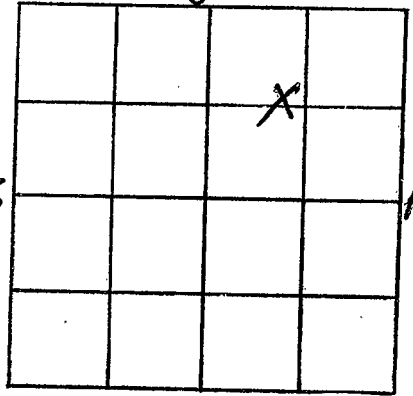

E SECTION 18

Please indicate well location X.

ADDITIONAL INFORMATION

If more than one screen,
show locations of each on sketch.