

Marshall
 N 2004
 6-9-76

MISSISSIPPI
 BOARD OF WATER COMMISSIONERS
 416 North State Street
 Jackson, Mississippi 39201

15E

WATER WELL DRILLERS LOG

6-9 1976 Dean Kent Bump ^{well} Marshall
 date well completed firm name county well located

LANDOWNER:

Mike Tyler
 Bogalua, Miss.
 (mailing address)

description of formations encountered

Sand

from

to

0 130

WELL LOCATION:

sec. 3 T 4 N R 4 E
 S W
 8 miles West of Holly Springs
 (distance) (direction) (nearest town)

WELL PURPOSE: Domestic
 (home, irrigation, municipal, industrial)

WELL COMPLETION DATA:


- (1) diameter (inches) 4"
- (2) total depth (feet) 130 feet
- (3) static water level (feet) 6' below top of ground.
- (4) casing PVC 130 feet
 (material) (depth)
- (size) if telescope see back.
- (5) screen 7 ft. 123 feet
 (length) (depth to top)
- 4" gravel wall
 (size) (material)
- (6) pump 3/4 14
 (HP) (yield gpm)
- (type power)
- (7) electric log Elect.
 (yes or no)
- (organization running log)
- (8) how well bottom plugged 4" cap

MISSISSIPPI BOARD OF WATER COMMISSIONERS
 JUNE 10 1976

DRILLERS REMARKS:

If well telescopes please sketch and show depths.

GROUND LEVEL

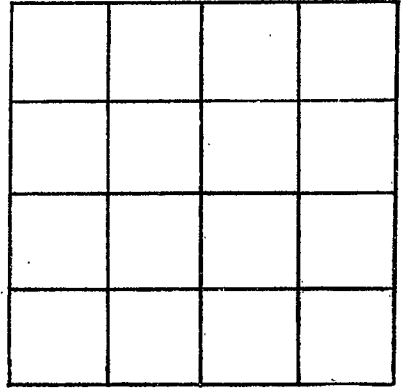

SECTION _____

Please indicate well location X.

ADDITIONAL INFORMATION

If more than one screen, show locations of each on sketch.