

MARSHALL  
N 2006  
7-15-76

MISSISSIPPI  
 BOARD OF WATER COMMISSIONERS  
 416 North State Street  
 Jackson, Mississippi 39201

WATER WELL DRILLERS LOG

7-15 1976 Hicks Well Co. Marshall  
 date well completed firm name county well located

LANDOWNER: R.H. Wages  
Rt. 3 Box 100D  
Holly Springs, Miss.  
 (mailing address)

description of formations encountered	from	to
	<u>Red clay</u>	<u>0</u>
<u>White Clay + Sand</u>	<u>40</u>	<u>160</u>
<u>White Sand</u>	<u>160</u>	<u>200</u>

WELL LOCATION:  
 sec. 31 T. 4 N R. 4 E  
4 miles NW of Chulahoma  
 (distance) (direction) (nearest town)

WELL PURPOSE: Home  
 (home, irrigation, municipal, industrial)

- WELL COMPLETION DATA:
- (1) diameter (inches) 4"
  - (2) total depth (feet) 200
  - (3) static water level (feet) 130 below above top of ground.
  - (4) casing PVC, 200,  
 (material) (depth)  
 (size) If telescope see back.
  - (5) screen 7ft, 193  
 (length) (depth to top)  
4" gravel  
 (size) (material)
  - (6) pump 1/2 5gal.  
 (HP) (yield gpm)  
220V  
 (type power)
  - (7) electric log NO  
 (yes or no)  
 (organization running log)
  - (8) how well bottom plugged cap


DRILLERS REMARKS:

RECEIVED

AUG 2 1976

If well telescopes please sketch and show depths.

GROUND LEVEL

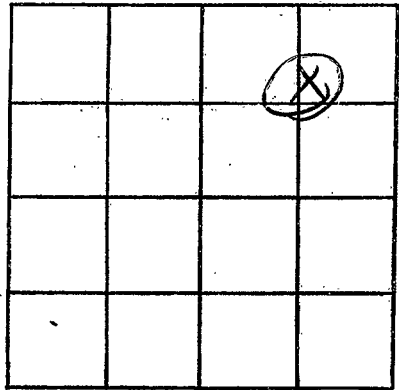

SECTION 31

Please indicate well location X.

ADDITIONAL INFORMATION

If more than one screen,  
show locations of each on sketch.