

Marshall
 N 2007
 7-13-76

MISSISSIPPI
 BOARD OF WATER COMMISSIONERS
 416 North State Street
 Jackson, Mississippi 39201

WATER WELL DRILLERS LOG

Marshall
 Tate

7-13-76
 date well completed

Bob Sizewell Sr.
 firm name

county well located


LANDOWNER:	description of formations encountered	from	to
Robt. Matthews			
(mailing address)	sand clay	5	40
	sand	40	150
WELL LOCATION:			
sec. <u>22</u> T <u>4</u> N R. <u>4</u> E			
<u>0</u> miles <u>0</u> of <u>Marion</u>			
(distance) (direction) (nearest town)			
WELL PURPOSE: (home, irrigation, municipal, industrial)			
WELL COMPLETION DATA:			
(1) diameter (inches) <u>4"</u>			
(2) total depth (feet) <u>150</u>			
(3) static water level (feet) <u>85</u> below top of ground.			
(4) casing <u>plastic</u> <u>10</u> (material) (depth)			
(size) If telescope see back.			
(5) screen <u>10</u> <u>140</u> (length) (depth to top)			
<u>4</u> <u>plastic</u> (size) (material)			
(6) pump <u>1/3</u> <u>5</u> (HP) (yield gpm)			
<u>E lec</u> (type power)			
(7) electric log <u>(yes or no)</u>			
(organization running log)			
(8) how well bottom <u>plugged</u>			
DRILLERS REMARKS:			

RECEIVED
 SEP 20 1976

MISS. BD. OF WATER COMM

If well telescopes please sketch and show depths.

GROUND LEVEL

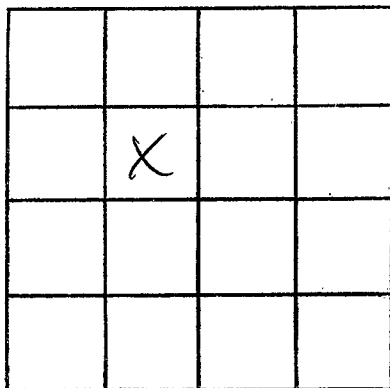

SECTION _____

Please indicate well location X.

ADDITIONAL INFORMATION

If more than one screen, show locations of each on sketch.