

Marshall
 N 2008
 9-11-76

MISSISSIPPI
 BOARD OF WATER COMMISSIONERS
 416 North State Street
 Jackson, Mississippi 39201

WATER WELL DRILLERS LOG


Sept 11 1976 date well completed
 Earl Jones Well 100 firm name
 Marshall county well located

LANDOWNER:	description of formations encountered	from	to
Hugh Mc Clatchey Red Bank, Miss (mailing address)			
WELL LOCATION:			
sec. 11 T. 4 N. R. 4 E 5 1/2 miles S of Red Bank (distance) (direction) (nearest town)			
WELL PURPOSE: Home (home, irrigation, municipal, industrial)			
WELL COMPLETION DATA:			
(1) diameter (inches) 4"			
(2) total depth (feet) 82			
(3) static water level (feet) 49 below top of ground.			
(4) casing plastic 72 (material) (depth) 4" (size) if telescope see back.			
(5) screen 10' 72 (length) (depth to top) 4" (size) plastic (material)			
(6) pump 1/2 (HP) 16 (yield.gpm) electric (type power)			
(7) electric log no (yes or no)			
(organization running log)			
(8) how well bottom plugged plastic cap			
DRILLERS REMARKS:			

RECEIVED
 OCT 12 1976

If well telescopes please sketch and show depths.

GROUND LEVEL

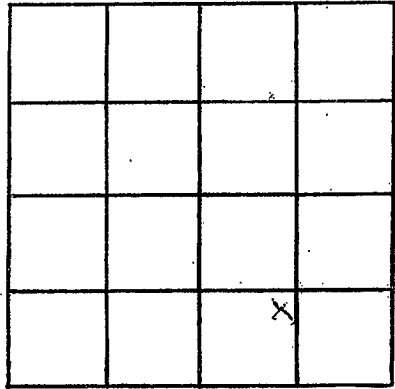

SECTION 77

Please indicate well location X.

ADDITIONAL INFORMATION

If more than one screen, show locations of each on sketch.