

Marshall  
 N 2009  
 9/16/76

15E

MISSISSIPPI  
 BOARD OF WATER COMMISSIONERS  
 416 North State Street  
 Jackson, Mississippi 39201

WATER WELL DRILLERS LOG

9-16 1976 Deantport Pump and Well Marshall  
 date well completed firm name county well located

LANDOWNER:  
 Mrs. L. L. Woods  
 Holly Springs, Miss.  
 (mailing address)

description of formations encountered	from	to
	clay	0
sand	20	160

WELL LOCATION:  
 sec. 15 T 7 N R 7 E  
 3 miles North of Marward  
 (distance) (direction) (nearest town)

WELL PURPOSE: Dwelling  
 (home, irrigation, municipal, industrial)

- WELL COMPLETION DATA:
- (1) diameter (inches) 4"
  - (2) total depth (feet) 160 feet
  - (3) static water level (feet) 110 below top of ground.
  - (4) casing PVC 160 feet (material) (depth)
  - (size) If telescope see back.
  - (5) screen 7 ft. 153 feet (length) (depth to top)
  - 4" gravel wall (size) (material)
  - (6) pump 3/4 HP 14 (HP) (yield gpm)
  - (type power)
  - (7) electric log elect. (yes or no)
  - (organization running log)
  - (8) how well bottom plugged 4" cof.


RECEIVED  
 OCT - 5 1976

MISS. BD. OF WATER COMMISSIONERS

DRILLERS REMARKS:

If well telescopes please  
sketch and show depths.

GROUND LEVEL

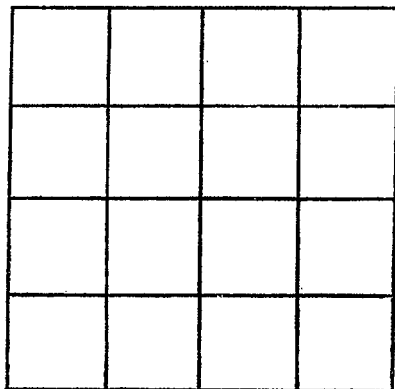

SECTION \_\_\_\_\_

Please indicate well location X.

ADDITIONAL INFORMATION

If more than one screen,  
show locations of each on sketch.