

Marshall
 N 2010
 9/24/76

MISSISSIPPI
 BOARD OF WATER COMMISSIONERS
 416 North State Street
 Jackson, Mississippi 39201

WATER WELL DRILLERS LOG

9-24 1976 Hicksville Co Marshall
 date well completed firm name county well located

LANDOWNER: Charles Woods

description of formations encountered	from	to
<u>Red Sand & Clay</u>	<u>0</u>	<u>105</u>
<u>Black Clay</u>	<u>105</u>	<u>185</u>
<u>White sand</u>	<u>185</u>	<u>215</u>

Byhalia, Miss. 38611
 (mailing address)

WELL LOCATION:

sec. 22 T. 4 N. R. 4 E. W
 (distance) miles (direction) of Marshall
 (nearest town)

WELL PURPOSE: home
 (home, irrigation, municipal, industrial)

WELL COMPLETION DATA:

- (1) diameter (inches) 4"
- (2) total depth (feet) 215
- (3) static water level (feet) 145 below above top of ground.
- (4) casing PVC 215
 (material) (depth)
 (size) if telescope see back.
- (5) screen 7 208
 (length) (depth to top)
4" gravel
 (size) (material)
- (6) pump 1/2 10
 (HP) (yield gpm)
225V
 (type power)
- (7) electric log no
 (yes or no)

(organization running log)

(8) how well bottom plugged cap


DRILLERS REMARKS:

RECEIVED
 OCT - 5 1976

MISS. BO OF WATER COMMISSIONERS

If well telescopes please sketch and show depths.

GROUND LEVEL

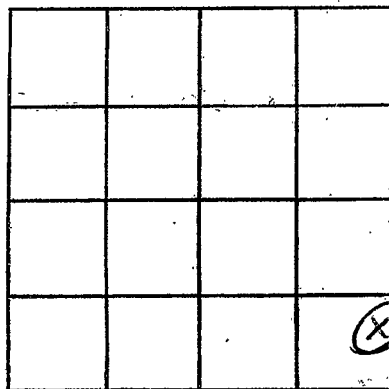

SECTION 22

Please indicate well location X.

ADDITIONAL INFORMATION

If more than one screen, show locations of each on sketch.