

March 28, 1977

Marshall  
N 2011

MISSISSIPPI  
BOARD OF WATER COMMISSIONERS  
416 North State Street  
Jackson, Mississippi 39201

WATER WELL DRILLERS LOG

3/1/77  
date well completed

Atkinson + Frost  
firm name

Marshall  
county well located

LANDOWNER: Allen Adams

description of formations encountered

from to

Memphis Tenn  
(mailing address)

Clay 0 12  
Sand 12 90  
Clay 90 120  
white sand 120 180  
Clay 180 240  
white sand 240 270

WELL LOCATION:

sec. 4 T 4 N R 4 E  
0 miles N of Chalmette  
(distance) (direction) (nearest town)

WELL PURPOSE: home  
(home, irrigation, municipal, industrial)

WELL COMPLETION DATA:

- (1) diameter (inches) 4"
- (2) total depth (feet) 270'
- (3) static water level (feet) 200' below top of ground.
- (4) casing PVC, 270' (material) (depth)
- (size) if telescope see back.
- (5) screen 10' (length), 260' (depth to top)
- 4" PVC (size) (material)
- (6) pump 3/4 (HP), 10 (yield gpm)
- Elec (type power)

(7) electric log (yes or no)

(organization running log)

(8) how well bottom plugged CAP.

RECEIVED


MAR 28 1977

DRILLERS REMARKS:

MISS. BD. OF WATER COMM

If well telescopes please sketch and show depths.

GROUND LEVEL

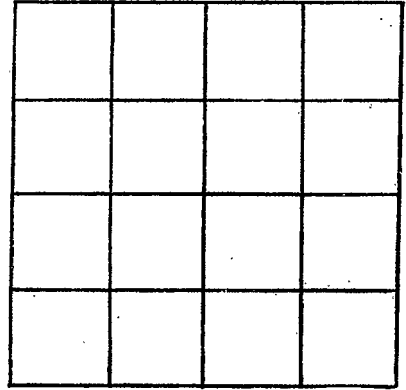

SECTION \_\_\_\_\_

Please indicate well location X.

ADDITIONAL INFORMATION

If more than one screen,  
show locations of each on sketch.