

**MARSHALL**  
 N 2013  
 8/1176

MISSISSIPPI  
 BOARD OF WATER COMMISSIONERS  
 416 North State Street  
 Jackson, Mississippi 39201

WATER WELL DRILLERS LOG

8-1-1976 <sup>156</sup> W.A. Mason Water Well Co. Marshall  
 date well completed firm name county well located

LANDOWNER:  
 Robert Foster  
 RFD, Hally Springs Miss.  
 (mailing address)

description of formations encountered	from	to
clay with	0	7
Red sand	7	45
white sand	45	190

WELL LOCATION:  
 sec. 31 T 4 N R. 4 E  
 1 1/2 miles South of Onion  
 (distance) (direction) (nearest town)

WELL PURPOSE: Home  
 (home, irrigation, municipal, industrial)

- WELL COMPLETION DATA:
- (1) diameter (inches) 4"
  - (2) total depth (feet) 190'
  - (3) static water level (feet) 160' below top of ground.
  - (4) casing (material) (depth) Plastic 180'
  - 2" if telescope see back.  
 (size)
  - (5) screen 10' 180'  
 (length) (depth to top)  
 4" Plastic  
 (size) (material)
  - (6) pump 3/4 10  
 (HP) (yield gpm)  
 electric  
 (type power)
  - (7) electric log No  
 (yes or no)

(organization running log)  
 (8) how well bottom plugged Cap


DRILLERS REMARKS:

RECEIVED  
 JUL 7 - 1976

MISS. DEPT. OF WATER CONTROL

If well telescopes please sketch and show depths.

GROUND LEVEL

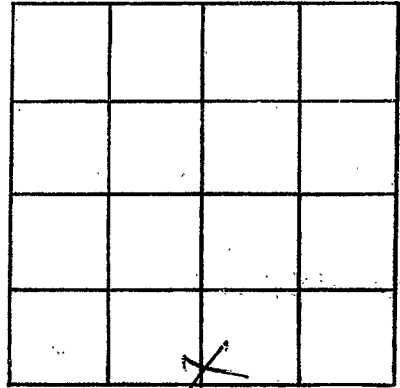

SECTION 31

Please indicate well location X.

ADDITIONAL INFORMATION

If more than one screen, show locations of each on sketch.