

MARSHALL
N 2014
8/20/76

MISSISSIPPI
 BOARD OF WATER COMMISSIONERS
 416 North State Street
 15E Jackson, Mississippi 39201

WATER WELL DRILLERS LOG

8-20- 19 76 W. R. Mason Water Well Drilling Marshall
 date well completed firm name county well located

LANDOWNER:
Ma Helen Griffin
Rt. Kelly Springs Miss
 (mailing address)

description of formations encountered	from	to
<u>clay sand</u>	<u>70</u>	<u>12</u>
<u>Red sand</u>	<u>12</u>	<u>80</u>
<u>white sand</u>	<u>80</u>	<u>155</u>

WELL LOCATION:
 sec 24 T 4 N R 4 E
1/2 miles East of Marion
 (distance) (direction) (nearest town)

WELL PURPOSE: Home
 (home, irrigation, municipal, industrial)

- WELL COMPLETION DATA:
- (1) diameter (inches) 4"
 - (2) total depth (feet) 155'
 - (3) static water level (feet) 85' below top of ground.
 - (4) casing Plastic, 145'
 (material) (depth)
4" if telescope see back.
 (size)
 - (5) screen 10', 145'
 (length) (depth to top)
4", Plastic
 (size) (material)
 - (6) pump 3/4 10
 (HP) (yield gpm)
Electric
 (type power)
 - (7) electric log NO
 (yes or no)

(organization running log)

(8) how well bottom plugged cap


DRILLERS REMARKS:

RECEIVED

JUL 7 1977

If well telescopes please sketch and show depths.

GROUND LEVEL

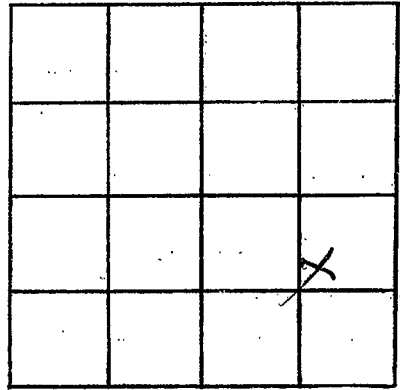

Please indicate well location X.

ADDITIONAL INFORMATION

If more than one screen, show locations of each on sketch.