

MARSHALL
 N 2015
 8-25-76

MISSISSIPPI
 BOARD OF WATER COMMISSIONERS
 416 North State Street
 Jackson, Mississippi 39201

WATER WELL DRILLERS LOG

8-25-76
 date well completed

W. G. Mason
 15E Wood Well Contr.
 firm name

Marshall
 county well located

LANDOWNER:

Francis McCammon
 Callisville Tenn.
 (mailing address)

description of formations encountered

from to

Clay	10	15
Red sand	15	80
white sand	80	211

WELL LOCATION:

sec 20 T 4 N R 4 E
 S W
 1/2 miles North of Orion
 (distance) (direction) (nearest town)

WELL PURPOSE: Home
 (home, irrigation, municipal, industrial)

WELL COMPLETION DATA:

- (1) diameter (inches) 4"
- (2) total depth (feet) 211
- (3) static water level (feet) 105 below top of ground.
- (4) casing Plastic 201, (material) (depth)
 4" (size) If telescope see back.
- (5) screen 10' 201' (length) (depth to top)
 4" Plastic (size) (material)
- (6) pump 1 1/2 30 (HP) (yield gpm)
 electric (type power)
- (7) electric log NO (yes or no)

(organization running log)

(8) how well bottom plugged Cap

RECEIVED


JUL 7 - 1977

DRILLERS REMARKS:

REC'D BY: [illegible]

If well telescopes please sketch and show depths.

GROUND LEVEL

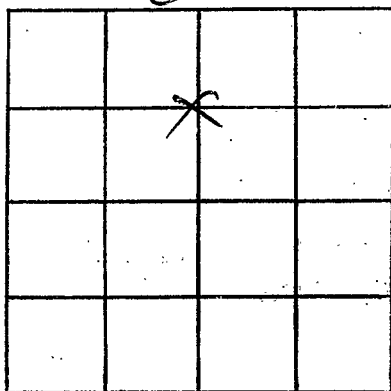

SECTION 20

Please indicate well location X.

ADDITIONAL INFORMATION

If more than one screen, show locations of each on sketch.